


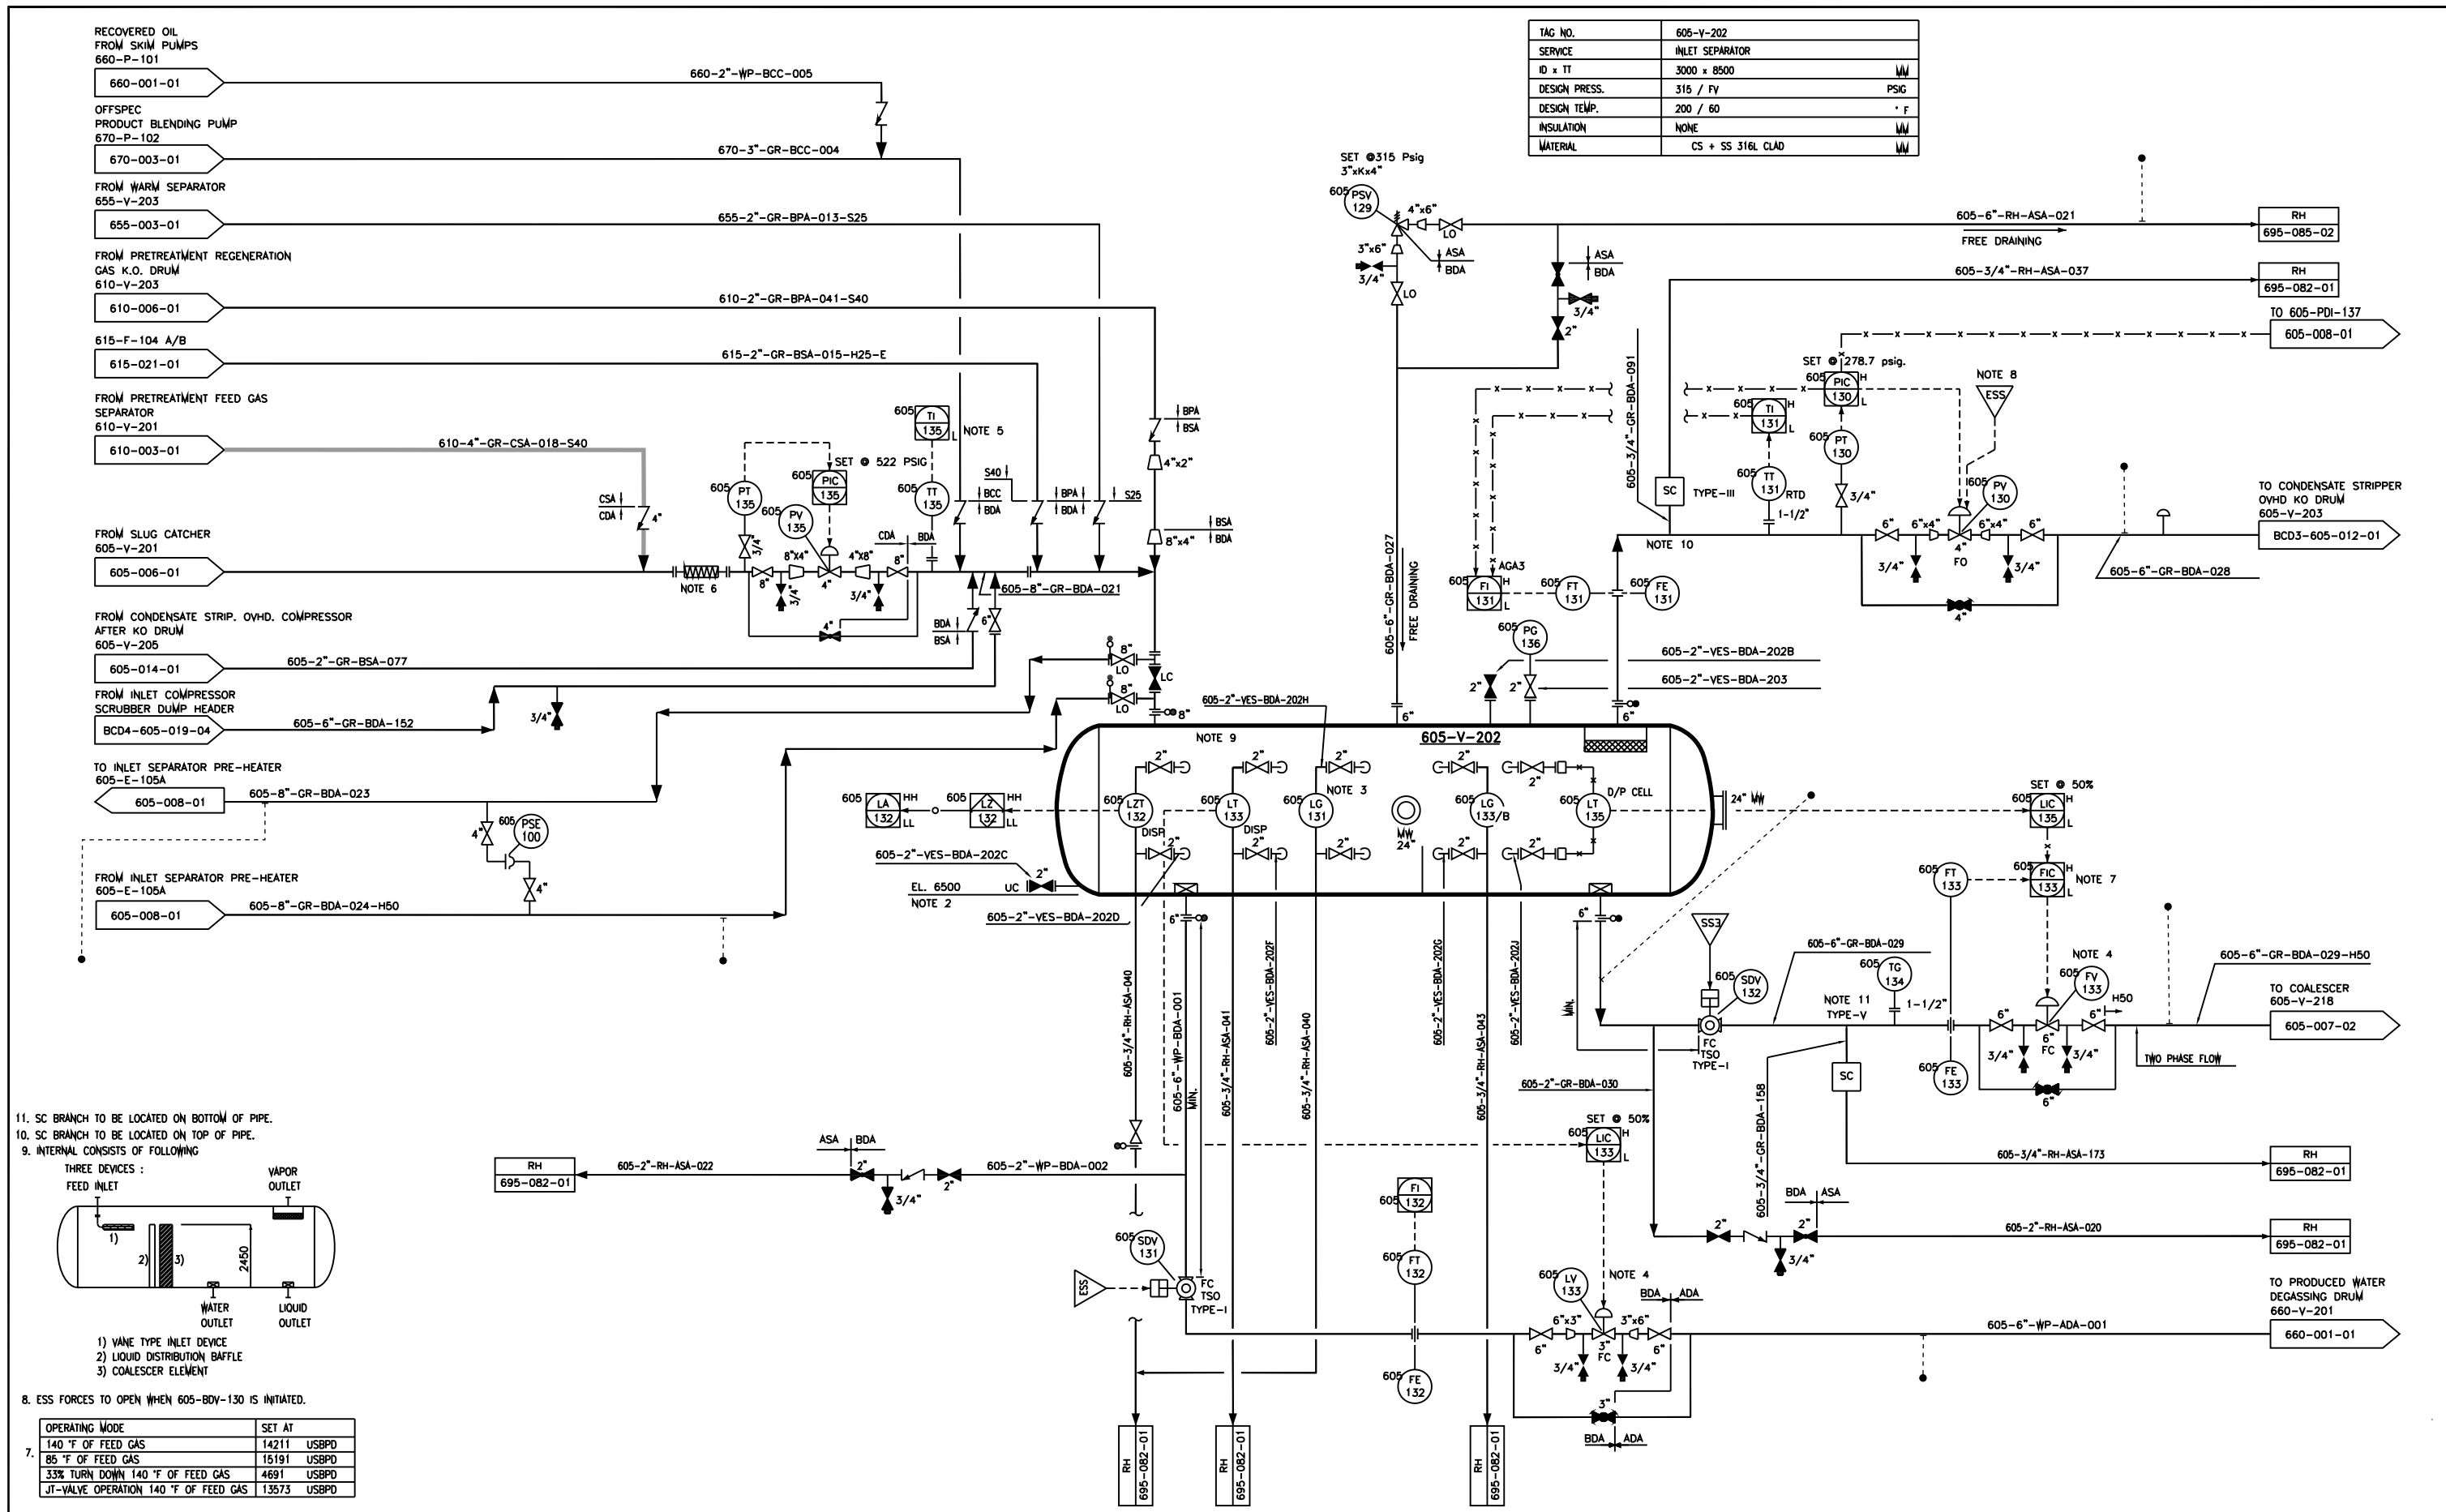

TAG NO.	605-V-202
SERVICE	INLET SEPARATOR
ID x TT	3000 x 8500
DESIGN PRESS.	315 / FY
DESIGN TEMP.	200 / 60
INSULATION	NONE
MATERIAL	CS + SS 316L CLAD

11. SC BRANCH TO BE LOCATED ON BOTTOM OF PIPE.
10. SC BRANCH TO BE LOCATED ON TOP OF PIPE.
9. INTERNAL CONSISTS OF FOLLOWING

THREE DEVICES :
FEED INLET
VAPOR OUTLET

1) VANE TYPE INLET DEVICE
2) LIQUID DISTRIBUTION BAFFLE
3) COALESCER ELEMENT

8. ESS FORCES TO OPEN WHEN 605-BDV-130 IS INITIATED.

OPERATING MODE	SET AT
140 °F OF FEED GAS	14211 USBPD
85 °F OF FEED GAS	15191 USBPD
33% TURN DOWN 140 °F OF FEED GAS	4691 USBPD
JT-VALVE OPERATION 140 °F OF FEED GAS	13573 USBPD

NOTES : 1. DELETED 2. VESSEL ELEVATION SET BY REQUIREMENT TO MAINTAIN SINGLE PHASE UPSTREAM OF FV-133. 3. TRANSPARENT TYPE LEVEL GAUGE. 4. IN CASE PSD, THE VALVE IS CLOSED AUTOMATICALLY OUTPUT : 4 mA MODE : MANUAL 5. ON AN INTERMITTENT AND SHORT DURATION THE OPERATOR COULD MANUALLY (THROUGH THE DCS) INCREASE THE TEMP. ON THE PRETREATMENT GAS CHILLER 610-E-103 (610-TIC-107). 6. STATIC MIXER.			REVISIONS	9	EB	24/02/12	AS BUILT						CLIENT	PetroChina International Jabung Ltd. Betara Complex Development Job No. : BCD - 335 - CA					
				8	NUR	08/07/11	AS BUILT	PBS/AW	SPD	ECR/RPS	RSD								
				7	EB	12/01/10	APPROVED FOR CONSTRUCTION	PBS/AW	SPD	ECR/RPS	RSD								
					6	YNT	23/10/09	FOR ACCEPTANCE	PBS/AW	SPD	ECR/RPS	RSD	CONTRACTOR	   PT MEINDO ELANG INDAH PT CAKRA NUSA DARMA PT SINGGAR MULIA					
					5	EB	04/09/09	FOR ACCEPTANCE	PBS/AW	SPD	ECR/RPS	RSD							
					4	EB	24/08/09	FOR DISCIPLINE COORDINATION	PBS/AW	SPD	ECR/RPS	RSD							
					3		01/05/09	RE-ISSUED FOR TENDER 07-1336											
					2	RF	25/10/07	AS BUILT AFTER 2007 SHUT DOWN	RF	RF	RF	MT							
		BCD4-000-42-PID-3-001-01~15		P&ID SYMBOLS											TITLE	PIPING AND INSTRUMENTATION DIAGRAM BETARA GAS PLANT INLET SEPARATOR			
	REFERENCE DWG NO	DESCRIPTION		REV	DRFT'G	DATE	DESCRIPTION	PREPARED BY	CHECKED BY	APPROVED BY	APPROVED BY		SIZE	SCALE	DRAWING No.	SHT No.	REV.		
													A3	NTS	BCD3-605-42-PID-3-007-01	1 OF 1	9		
CAD FILE NAME : BCD3-605-42-PID-3-007-01_9.DWG																			