
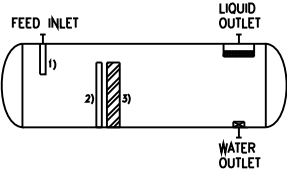


TAG NO.	605-V-206		
SERVICE	WATER DRAW POT		
ID x TT	1200 x 3800	MM	
DESIGN PRESS.	300 / FV	PSIG	
DESIGN TEMP.	411 / 40	°F	
INSULATION	HOT 50	MM	
MATERIAL	CS + SS 316L CLAD		

NOTES

1. INTERNAL CONSISTS OF FOLLOWING THREE DEVICES :
- 
- 1) PERFORATED PIPE INLET DEVICE
2) LIQUID DISTRIBUTION BAFFLE
3) COALESCER ELEMENT
2. IN CASE PSD, THE VALVE IS CLOSED AUTOMATICALLY
OUTPUT : 4 mA
MODE : MANUAL

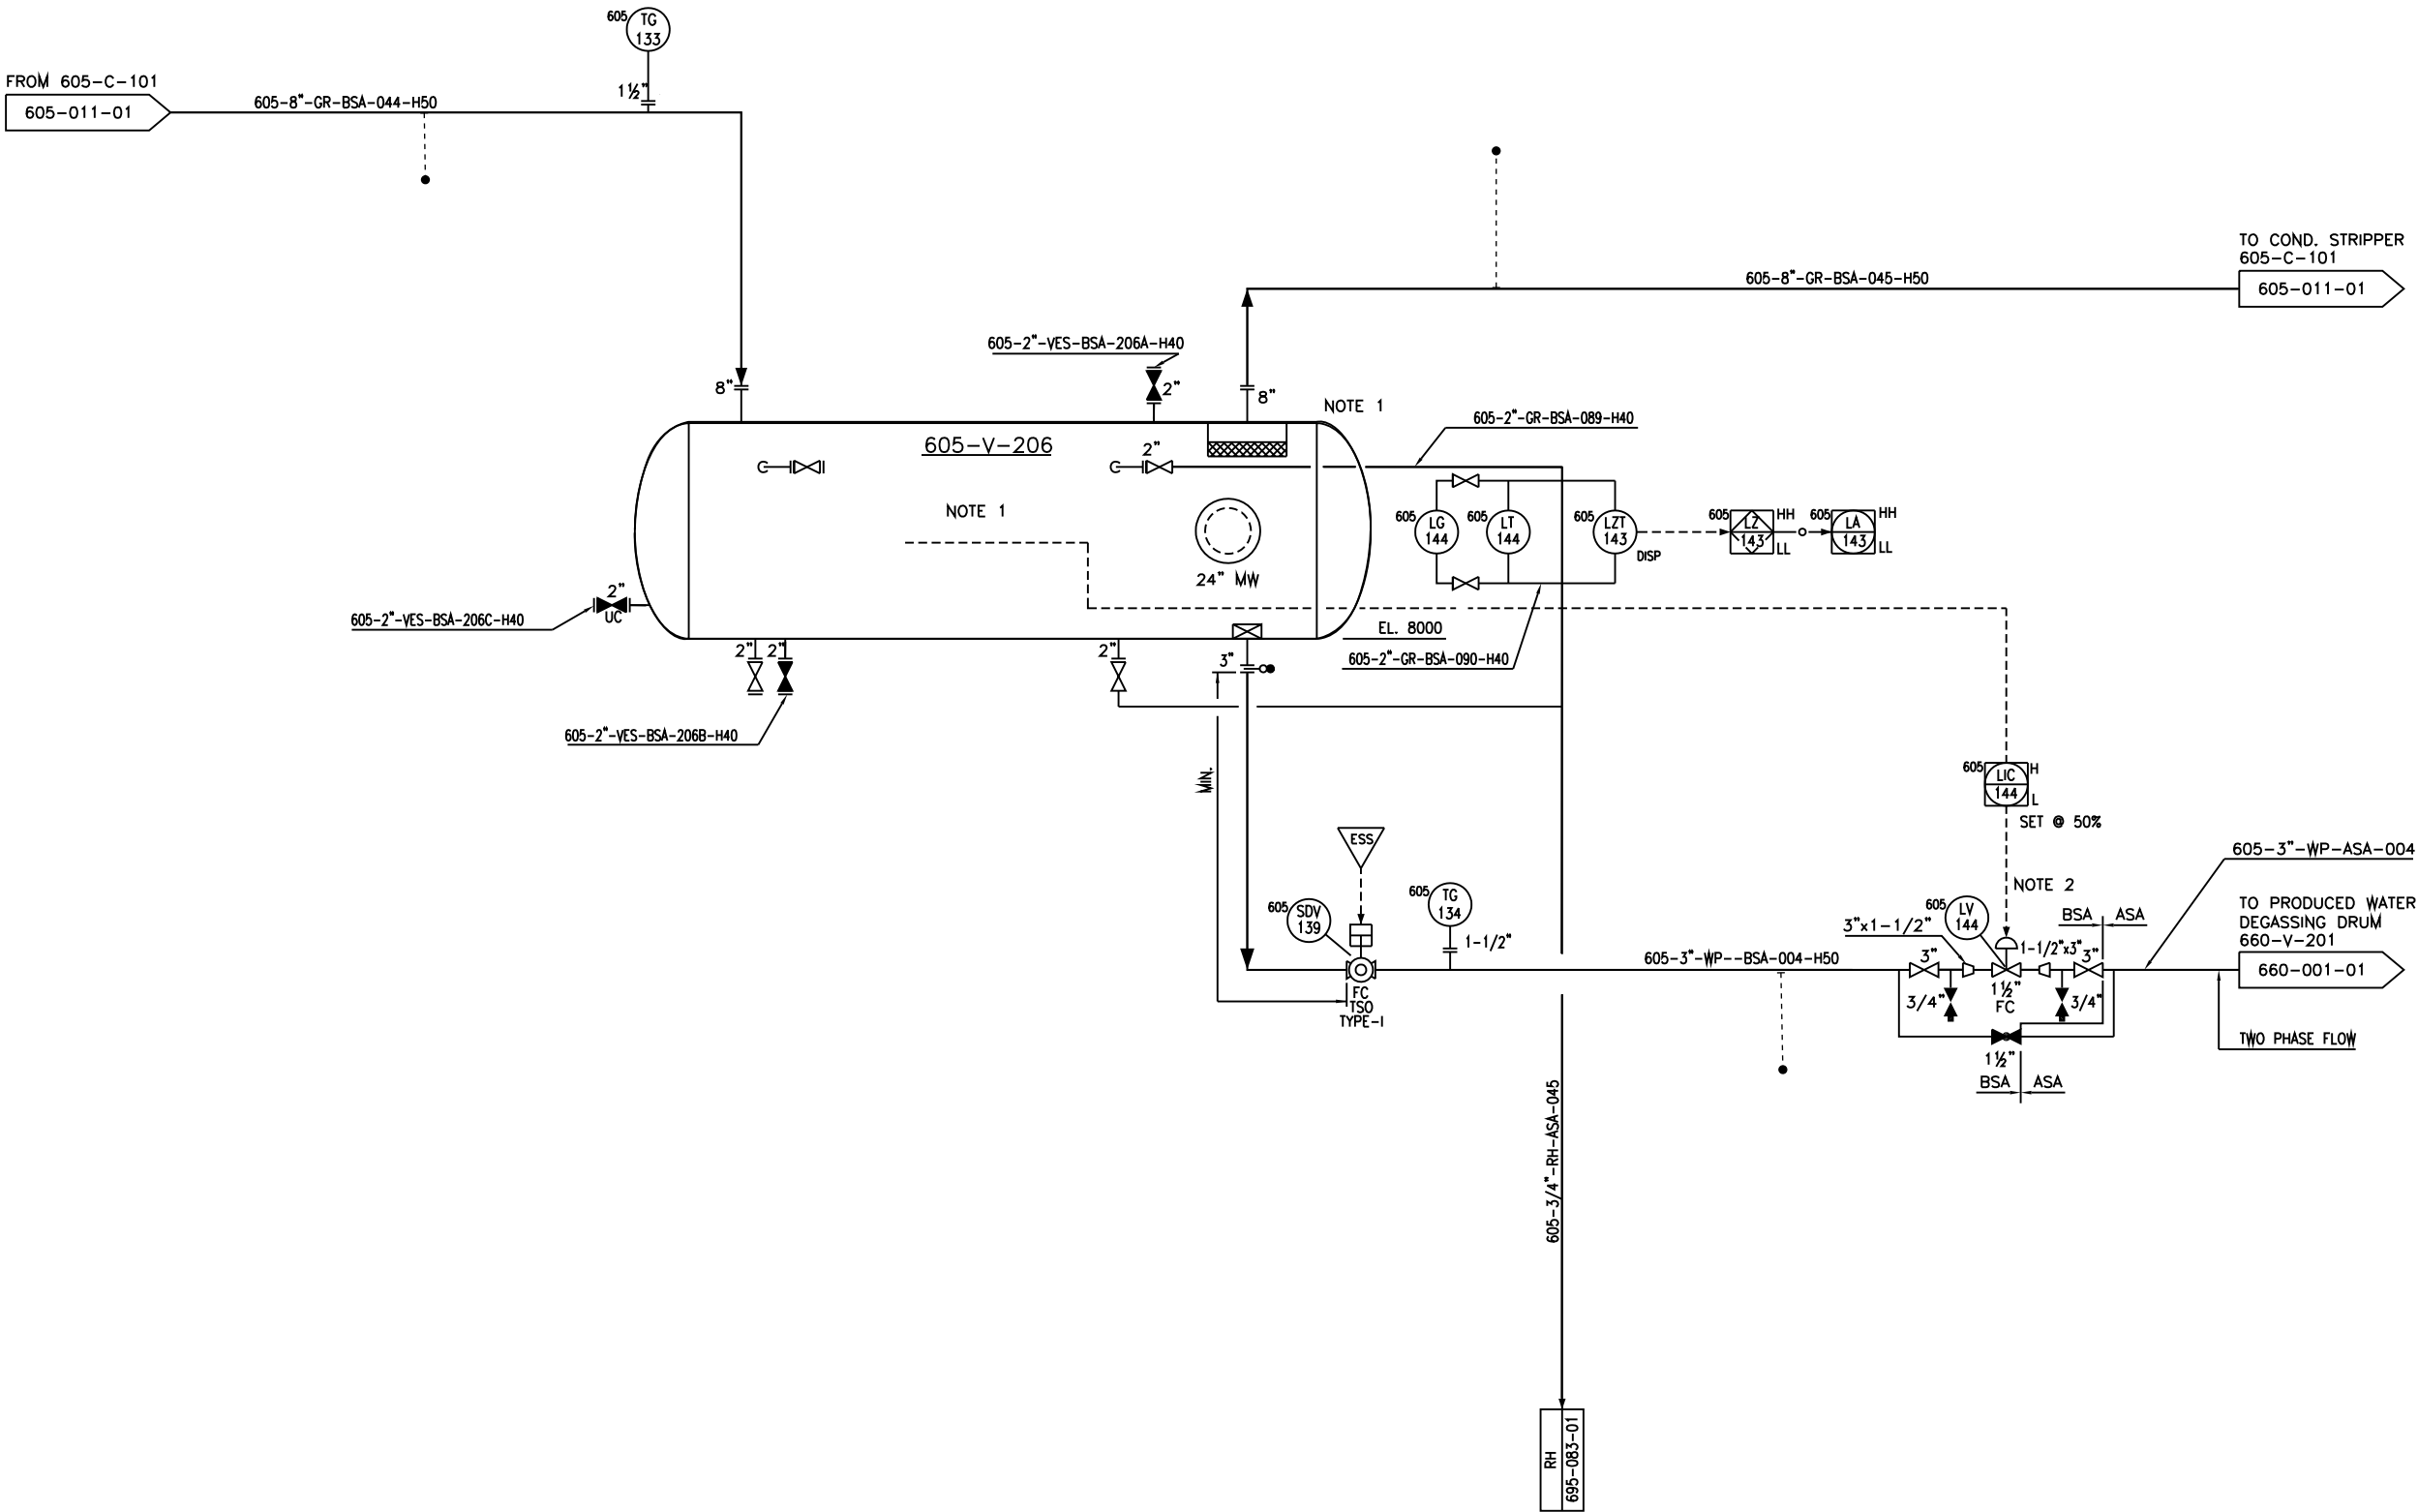

BCD3-605-42-PID-1-011-01			CONDENSATE STRIPPER				
BCD3-000-42-PID-1-001-01 to 012			P&ID SYMBOLS				
NO.			REFERENCE DOCUMENT				
REV.	ISSUED	PURPOSE	LDE	PEW	PM	STATUS	DATE
COMPANY STATUS							
2	AS BUILT AFTER 2007 SHUT DOWN	25-OCT-07	RF	RF	RF	RF	VI
1	AS BUILT	13-OCT-06	RF	RF	RF	RF	VI
0	INCLUDING HAZOP COMMENTS	13-JUNE-06	non	JH	RF	RF	VI
NO.	DESCRIPTION	DATE	BY	CHKD	RYD	APVD	
CONTRACTOR REVISIONS							
 PT. CHIYODA INTERNATIONAL INDONESIA			 PT. Sempec Indonesia				
CONTRACT			JOB		E3X01		
PetroChina International Jabung Ltd.							
BETARA COMPLEX DEVELOPMENT							
PIPING AND INSTRUMENTATION DIAGRAM							
BETARA GAS PLANT							
WATER DRAW POT							
SCALE : NTS							
DOCUMENT			REVISION				
BCD3-605-42-PID-1-011-03			2				