

TAG. NO	605-E-102
SERVICE	CONDENSATE STRIPPER OVHD COMP. AFTER COOLER
TYPE/SURFACE (FIN)	FORCED / 1.89E + 06 M2
HEAT DUTY	3.97 e+6 BTU/HR
DESIGN PRESS.	800 / FV PSIG
DESIGN TEMP.	300 ° F
DRIVER	7.5 KW
MATERIAL	SS 316L


TAG NO.	605-V-205
SERVICE	CONDENSATE STRIPPER OVHD COMPRESSOR AFTER K.O. DRUM
ID x TT	900 x 2900 MM
DESIGN PRESS.	800 / FV PSIG
DESIGN TEMP.	240 / 40 ° F
INSULATION	NONE
MATERIAL	CS + SS 316L CLAD

NOTES

1. NO. OF BAY : 1 BAY
2. FANS FOR EACH BAY.

BAY'S TAG	FAN MOTOR'S TAG
605-E-102-01	605-EM-102 A1
	605-EM-102 A2

3. IN CASE PSD, THE VALVE IS CLOSED AUTOMATICALLY
OUTPUT : 4 mA
MODE : MANUAL

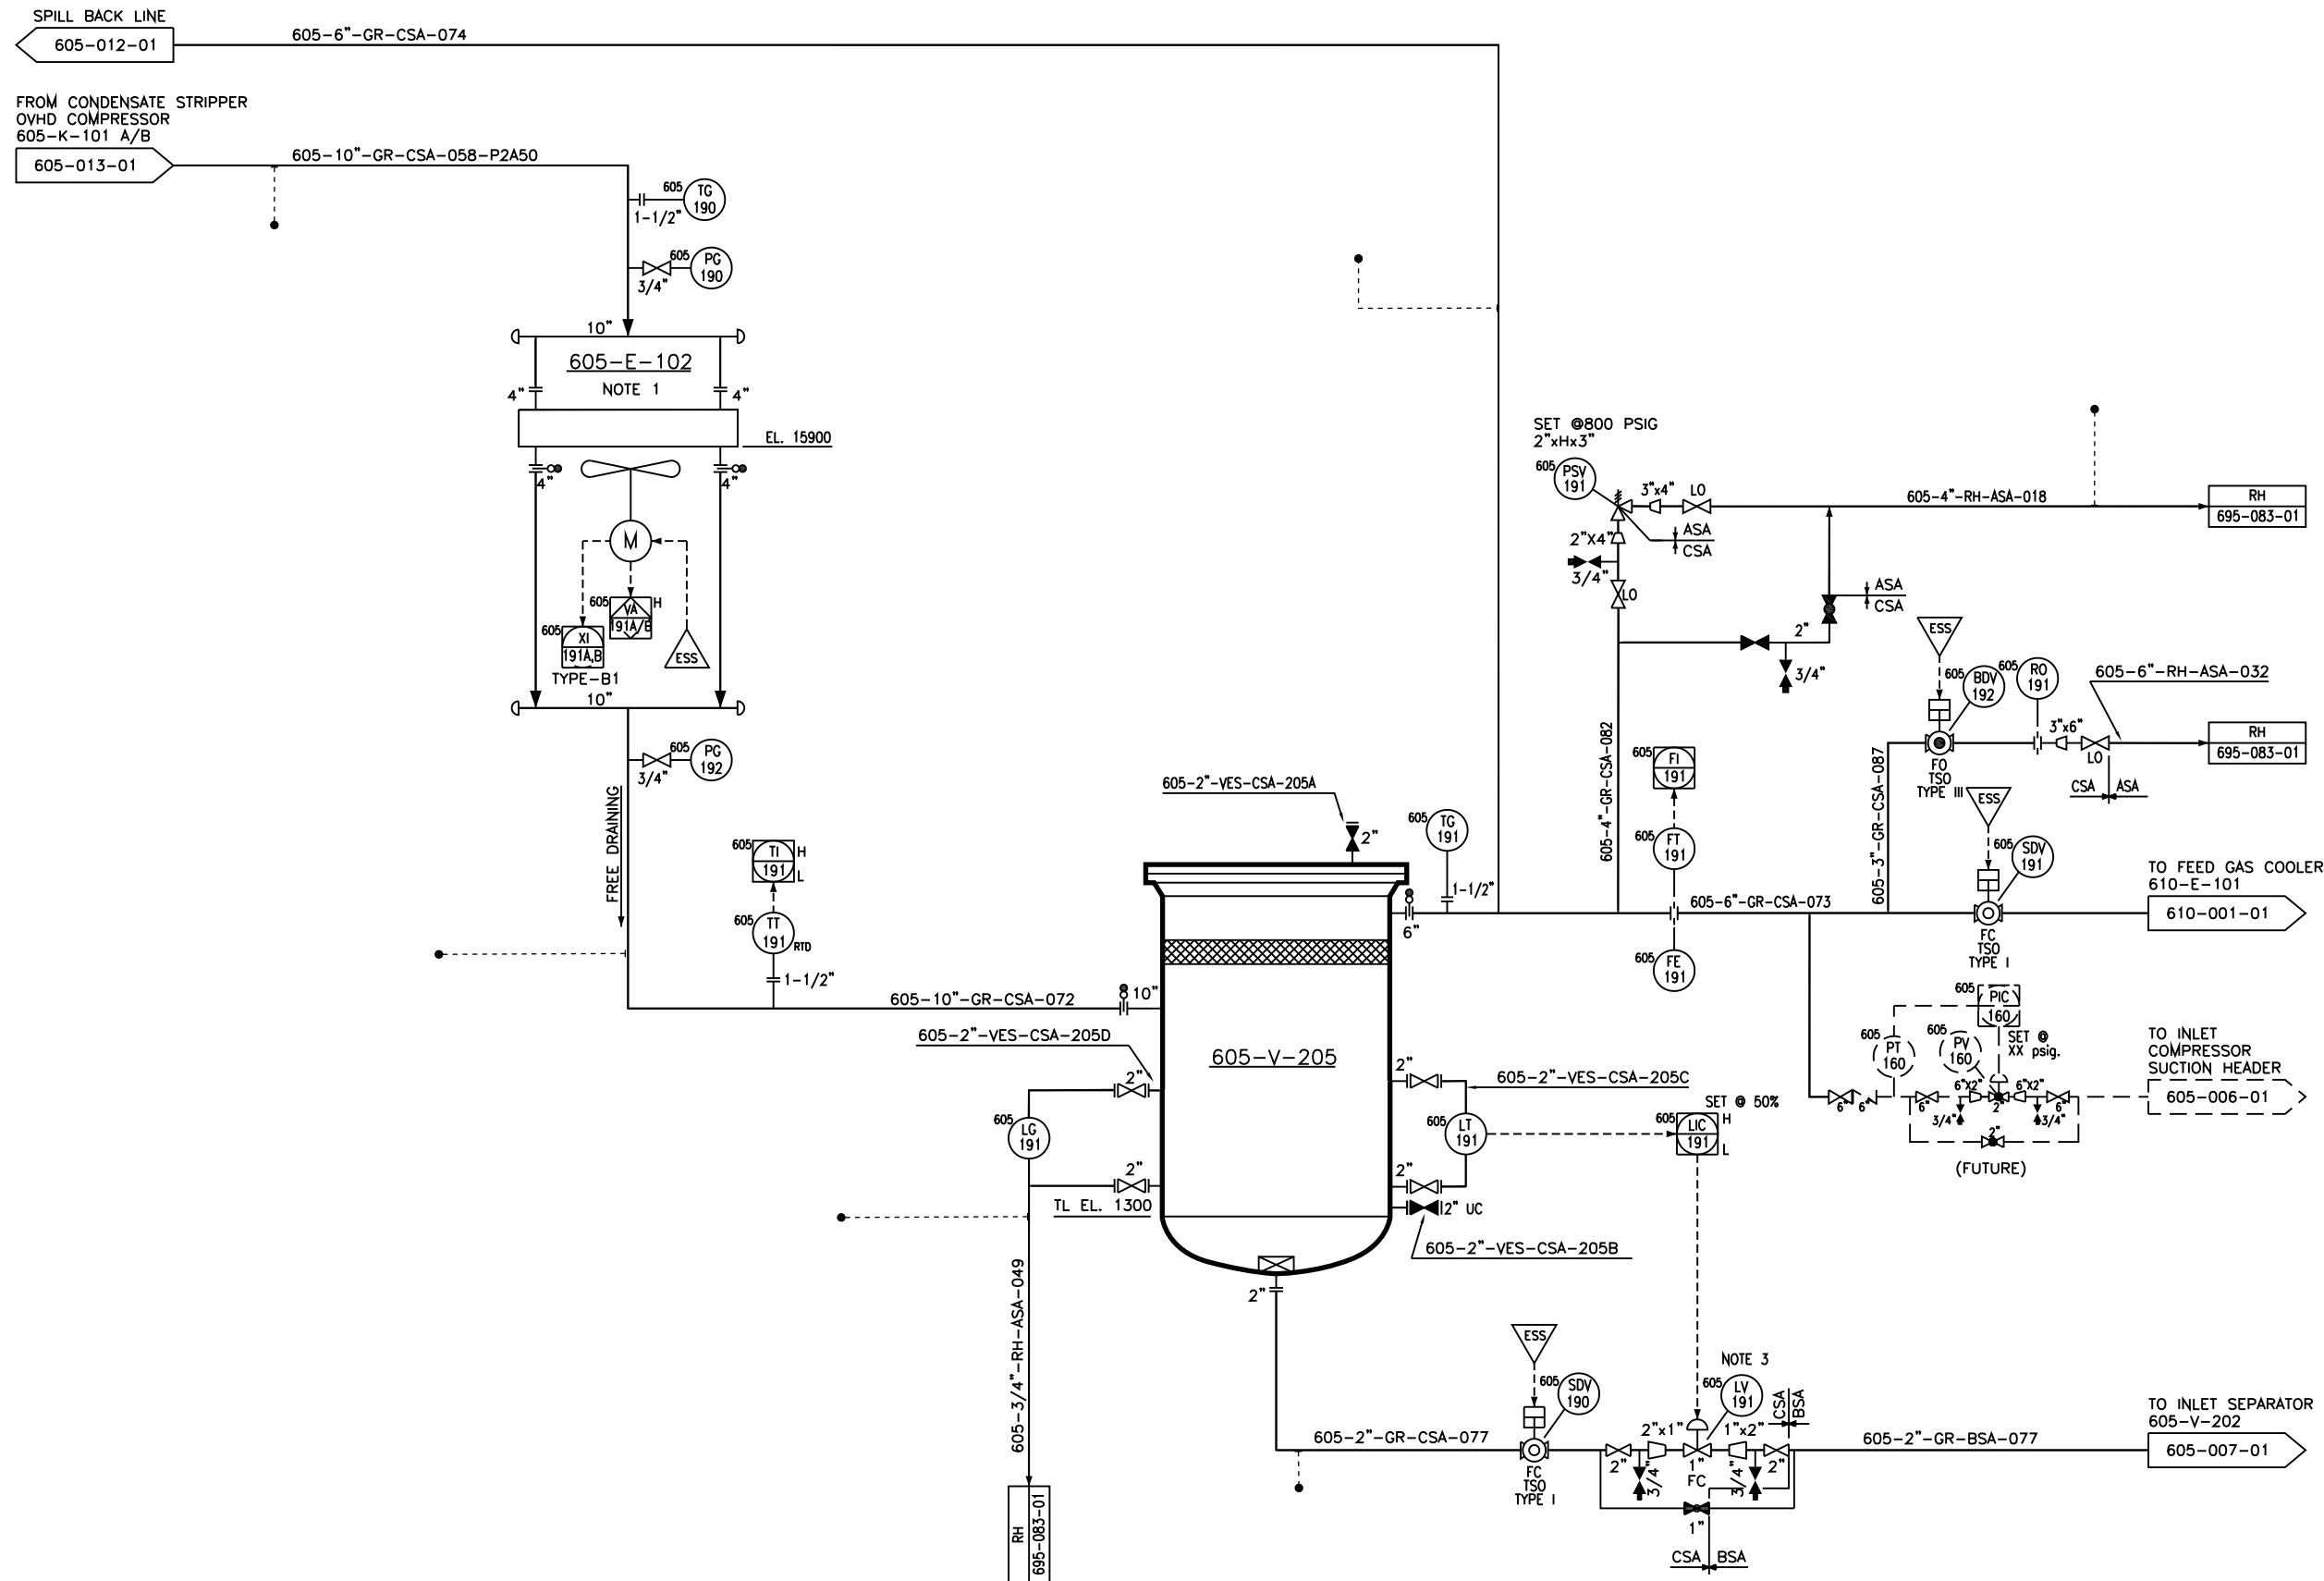

BAY'S TAG

FAN MOTOR'S TAG

NOTES

1. NO. OF BAY : 1 BAY

2. FANS FOR EACH BAY.

3. IN CASE PSD, THE VALVE IS CLOSED AUTOMATICALLY

OUTPUT : 4 mA

MODE : MANUAL

REV. ISSUED PURPOSE LDE PEM PM STATUS DATE

COMPANY STATUS

AS BUILT 22-MAR-12

ISSUED FOR CONSTRUCTION 28-APR-11 SDW AOS BG RSK

FOR REVIEW 20-MAR-11 SDW AOS BG

FOR DISPLINE COORDINATION 11-FEB-11 SDW AOS BG

AS BUILT 16-JUL-06 ASH JH BS TU

ISSUED FOR CONSTRUCTION 11-MAY-06 ASH JH BS TU

ISSUED FOR CONSTRUCTION 09-SEPT-04 ASH RF BS TU

ISSUED FOR CONSTRUCTION 19-JUNE-04 ASH RF BS TU

ISSUED FOR CONSTRUCTION 27-MAR-04 ASH RF BS TU

ISSUED FOR CONSTRUCTION 14-JAN-04 ASH RF BS TU

ISSUED FOR HAZOP 19-SEPT-03 ASH RF BS TU

ISSUED FOR HAZOP 08-SEPT-03 ASH RF BS TU

NO. DESCRIPTION DATE BY CHKD RYO APVD

CONTRACTOR REVISIONS

PT. CHIYODA INTERNATIONAL INDONESIA PT. Sempec Indonesia

CONTRACT JOB E3X01

PetroChina International Jabung Ltd.

BETARA COMPLEX DEVELOPMENT

PIPING AND INSTRUMENTATION DIAGRAM

BETARA GAS PLANT

CONDENSATE STRIPPER OVERHEAD COMPRESSOR

(3/3)

SCALE : NTS

DOCUMENT

BCD3-605-42-PID-1-014-01

REVISION

6

FILE NAME : BCD3-605-42-PID-1-014-01.Rvt.DWG