


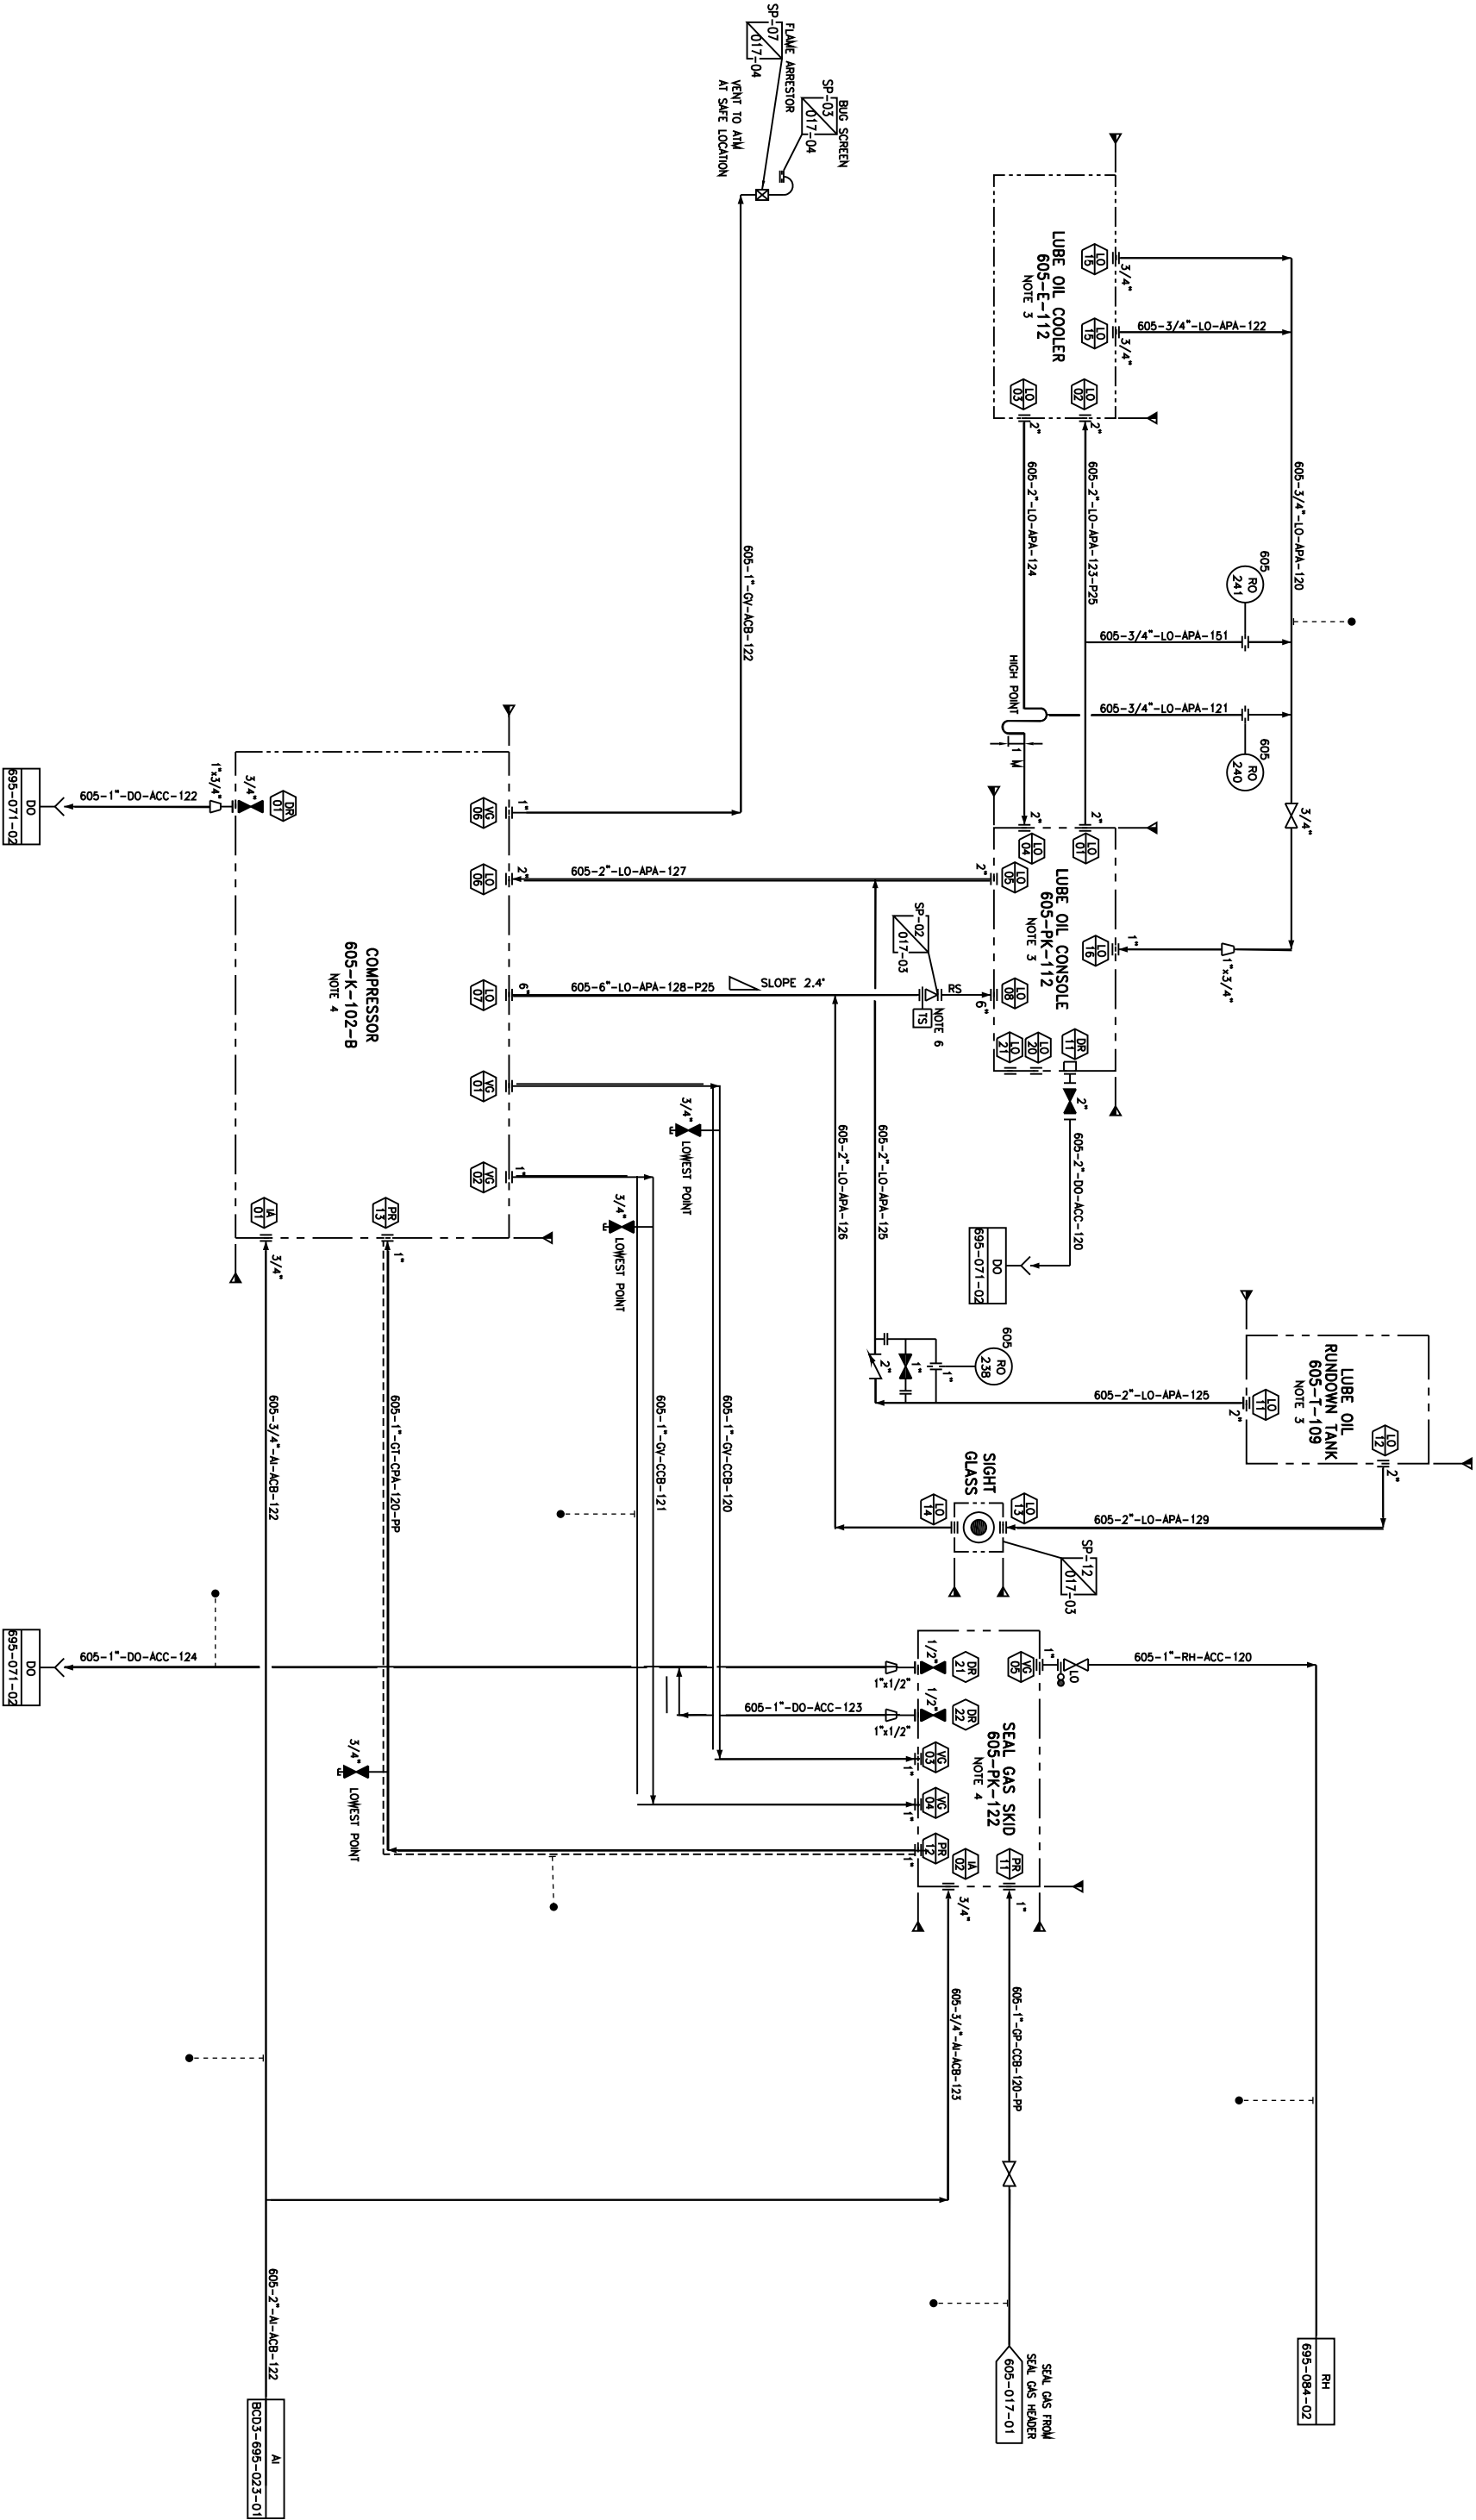

1. SCOPE OF SUPPLY		MARKED EQUIPMENT AND AUXILIARY ARE SUPPLIED BY VENDOR.		BY CONTRACTOR		BY VENDOR	
2. DELETED DRAWING OF TYPICAL LUBE COOLER OIL AND LUBE OIL CONSOLE REFER TO HITACHI DRAWING NO.3M4-2187213		3. DELETED DRAWING OF TYPICAL COMPRESSOR REFER TO HITACHI DRAWING NO.3M4-2187215		4. DETAILED DRAWING OF TYPICAL COMPRESSOR REFER TO HITACHI DRAWING NO.3M4-2187215		5. 10 FT ABOVE GRADE OUTSIDE SHELTER	
6. REMOVABLE SPOOL FOR TEMPORARY STRAINER WHILE OIL FLUSHING.		BCD4-000-42-PID-1-001-01-015		REFERENCE DWG NO		DESCRIPTION	
REVISIONS		REV	DATE	DESCRIPTION	PREPARED BY	CHECKED BY	APPROVED BY
AS BUILT		EB	30/03/12	AS BUILT	PBS/AM	SPD	ECR/RPS
AS BUILT		NUR	21/06/11	AS BUILT	PBS/AM	SPD	ECR/RPS
APPROVED FOR CONSTRUCTION		EB	12/01/10	APPROVED FOR CONSTRUCTION	PBS/AM	SPD	ECR/RPS
FOR ACCEPTANCE		EB	23/10/09	FOR ACCEPTANCE	PBS/AM	SPD	ECR/RPS
FOR ACCEPTANCE		EB	04/08/09	FOR ACCEPTANCE	PBS/AM	SPD	ECR/RPS
FOR DISCIPLINE COORDINATION		DP	24/06/09	FOR DISCIPLINE COORDINATION	PBS/AM	SPD	ECR/RPS
CLIENT		PetroChina International Jabung Ltd. Betara Complex Development Job No. : BCD - 335 - CA		CONTRACTOR		TITLE	
PT BENDOWELANG NINDI		PT OKARA NUSI DARMA		PT SENGAR MULA		PIPE AND INSTRUMENTATION DIAGRAM	
INLET COMPRESSOR-B INTERCONNECTING PIPING DIAGRAM		DRAWING No.		SIT No.		REV.	
A3		SCALE		NTS		BCD4-605-42-PID-3-017-03	
3 OF 4		REV.		2		CNO FILE NAME : BCD-605-42-PID-3-017-03.2.DWG	