


TAG NO.	605-V-2204
SERVICE	INLET COMPRESSOR SUCTION SCRUBBER A
ID x TT	1190 x 3014
DESIGN PRESS.	675/PSI
DESIGN TEMP.	200 / 55
INSULATION	None
MATERIAL	CS + SS 316 L CLAD
TRIM MATERIAL	SS 316 L

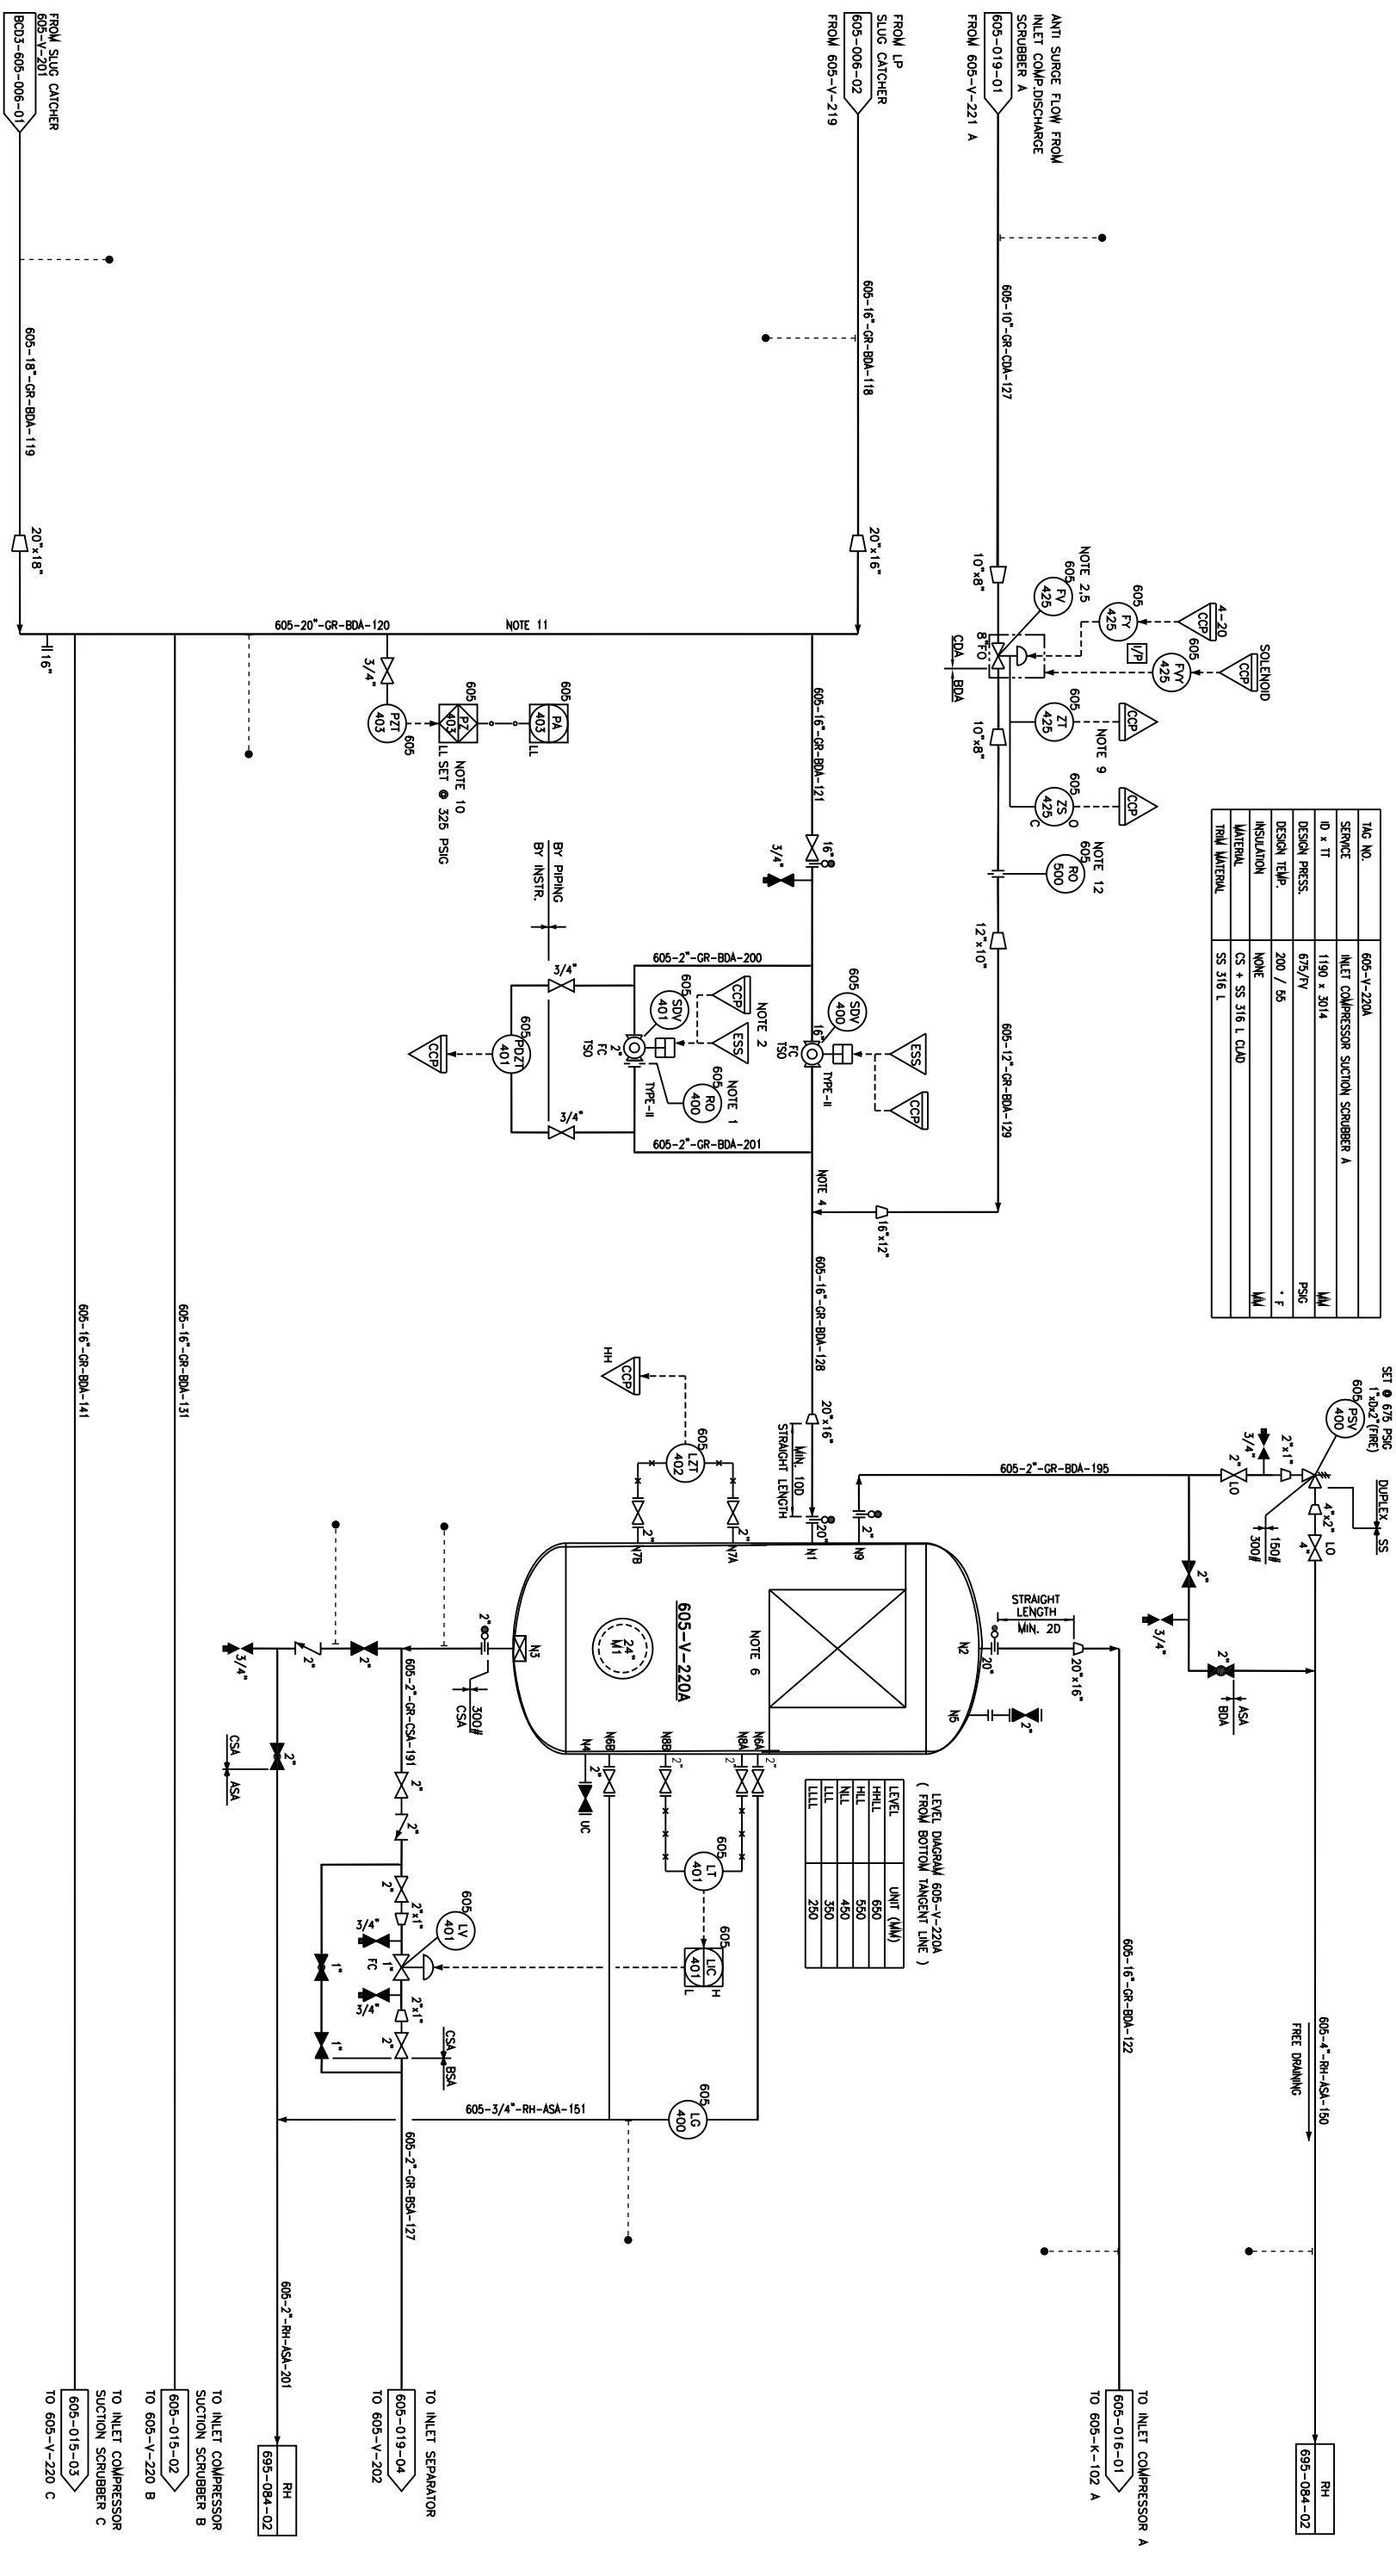

1. RO IS USED FOR PRESSURISING THE COMPRESSOR.
2. TO PROVIDE MANUAL OVERRIDE FROM DCS.
3. DELETED
4. USE EQUAL TEES TO MINIMIZE FLOW INDUCED RESONANCE ON NON-FLOWING LINES CONNECTIONS
5. DELETED
6. AIN SOURCE VALVE TO BE PROVIDED BY INLET COMPRESSOR VENDOR
7. DELETED
8. DELETED
9. 4-20 mA = 0-100% TRAVEL.
10. 603-P41L-403 SHALL BE 3 COMPRESSOR PACKAGES VIA ESS TO EACH COMPRESSOR'S CCP (UT-412, UT-432, UT-452).
11. 20" BDA CLASS PIPING HAS PRESSURE RATING OF 660 PSIG
12. RO IS SUPPLIED BY VENDOR.

PetroChina International Jabung Ltd. Betara Complex Development Job No. : BCD - 335 - CA									
TITLE PIPING AND INSTRUMENTATION DIAGRAM BETARA GAS PLANT INLET COMPRESSOR SUCTION SCRUBBER-A									
SIZE SCALE NTS DRAWING No. BCD-000-42-PID-3-015-01 SHEET No. 1 OF 3 REV. A									
CLIENT CONTRACTOR PT MEDIANE ELANG NINDAH PT CIBERA NUSA DARMAS PT SINGGAR MUDA									
REVISIONS									
Δ									
Δ	EB	30/03/12	AS BUILT						
Δ	NUR	21/06/11	AS BUILT						
Δ	EB	05/02/10	APPROVED FOR CONSTRUCTION	PBS/AN	SPD	ECR/RPS	RSD		
Δ	EB	23/10/09	FOR ACCEPTANCE	PBS/AN	SPD	ECR/RPS	RSD		
Δ	EB	04/09/09	FOR ACCEPTANCE	PBS/AN	SPD	ECR/RPS	RSD		
Δ	DP	24/08/09	FOR DISCIPLINE COORDINATION	PBS/AN	SPD	ECR/RPS	RSD		
REFERENCE DWG NO DESCRIPTION									
BCD-000-42-PID-1-001-01~15 P&ID SYMBOLS									