
TAG. NO	605-E-104
SERVICE	NGL RUNDOWN COOLER
TYPE/SURFACE (FIN)	FORCED DRAFT / 3.69E + 06 M2
HEAT DUTY	1.161 E+07 BTU/HR
DESIGN PRESS.	300 / FV PSIG
DESIGN TEMP.	411 ° F
DRIVER	22.4 KW
MATERIAL	CS + CA 3 MM

TAG. NO	605-P-109
SERVICE	FAST LOOP PUMP
CAPACITY	2.33 GPM (530 L/H)
SIFF. PRESS.	29 PSI
DRIVER	2.2 KW
API STANDARD	API 675

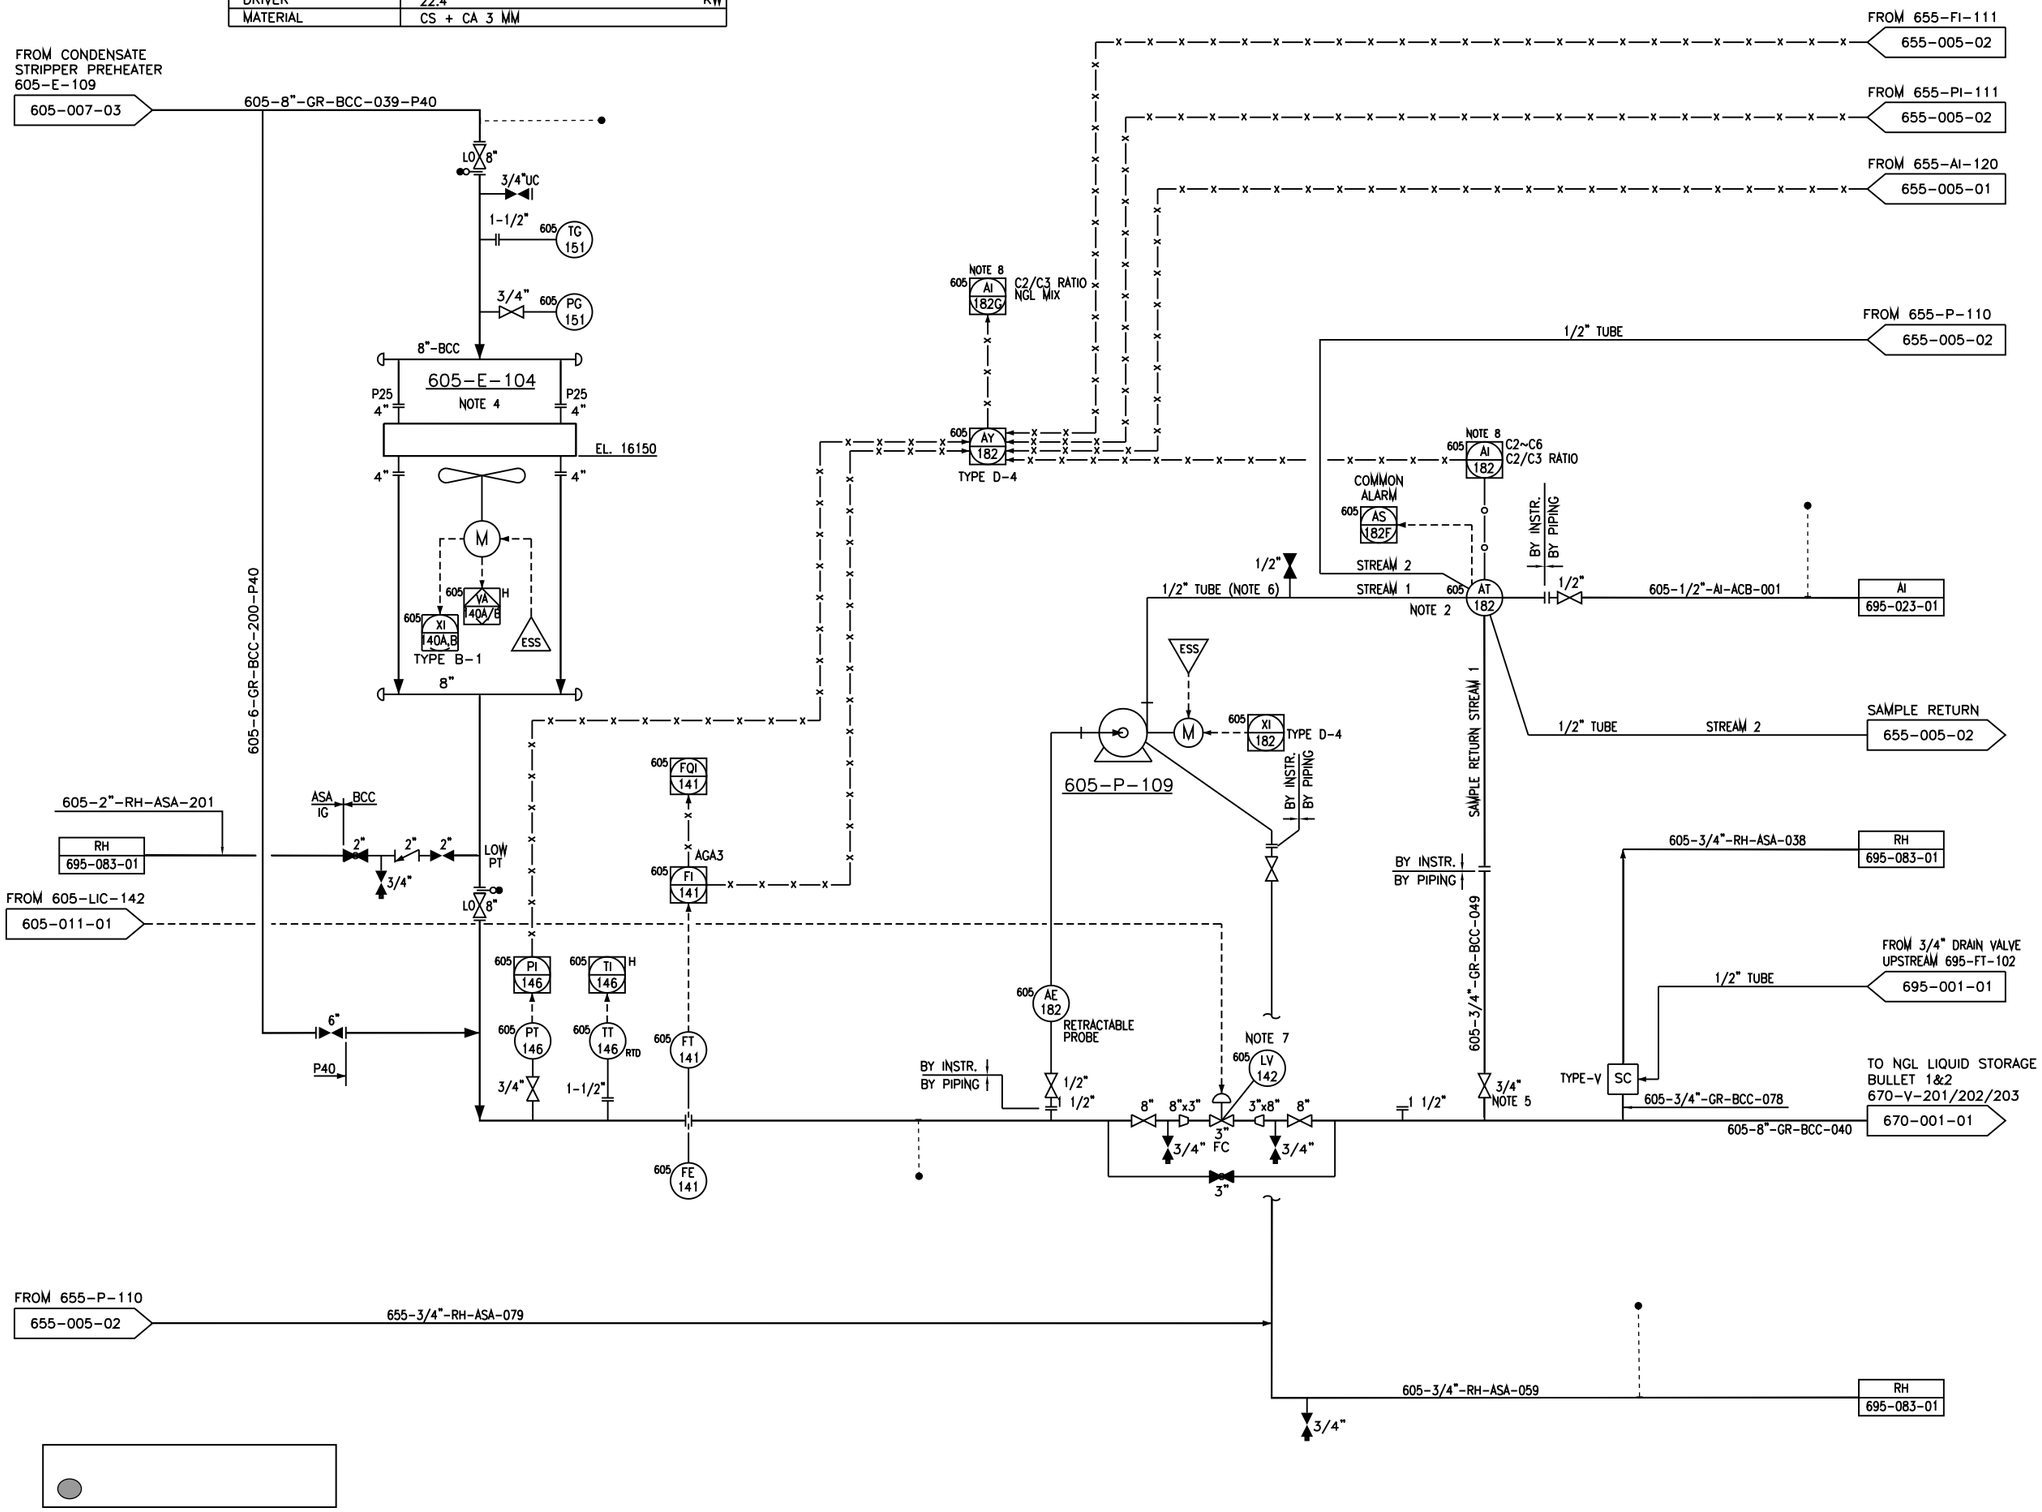

NOTES

1. DELETED.
2. THE GC SHELTER IS EQUIPPED WITH SAMPLE RECOVERY PUMP.
3. DELETED
4. NO. OF BAY : 1 BAY
 2 FANS FOR EACH BAY.

BAY'S TAG	FAN MOTOR'S TAG
605-E-104-01	605-EM-104 A1
	605-EM-104 A2

5. THE TAPPING LOCATION IS NEAR BY ANALYZER SHELTER NO. 600-SHT-127.
6. THE MAX DISTANCE IS 25 M.
7. IN CASE PSD, THE VALVE IS CLOSED AUTOMATICALLY
 OUTPUT : 4 mA
 MODE : MANUAL
8. IDENTIFIED COMPONENT DATA BOX

ANALYZER	IDENTIFIED COMPONENT
605-AI-182	C2, C3, C4, C5, C6, C2/C3 RATIO
605-AI-182G	C2/C3 RATIO, NGL MIX

BCD3-000-42-PID-1-001-01 TO 012 P&ID SYMBOLS

NO. REFERENCE DOCUMENT

REV.	ISSUED	PURPOSE	LDE	PEM	PM	STATUS	DATE
COMPANY STATUS							
7	AS-BUILT						14-MAR-12
6.10	ISSUED FOR CONSTRUCTION						20-DEC-10
6	RE-AS BUILT						12-JULY-06
5	AS-BUILT						18-JULY-05
4	ISSUED FOR CONSTRUCTION						11-MAY-05
3	ISSUED FOR CONSTRUCTION						26-JULY-04
2	ISSUED FOR CONSTRUCTION						19-JUNE-04
1	ISSUED FOR CONSTRUCTION						27-MAR-04
0	ISSUED FOR CONSTRUCTION						14-JAN-04
NO.	DESCRIPTION		DATE	BY	CHKD	RVD	APVD

7	AS-BUILT	14-MAR-12				
6.10	ISSUED FOR CONSTRUCTION	20-DEC-10	SDW	ADS	BG	RSK
6	RE-AS BUILT	12-JULY-06	non	JW	BS	TU
5	AS-BUILT	18-JULY-05	non	JW	BS	TU
4	ISSUED FOR CONSTRUCTION	11-MAY-05	ASW	JW	BS	TU
3	ISSUED FOR CONSTRUCTION	26-JULY-04	ASW	RF	BS	TU
2	ISSUED FOR CONSTRUCTION	19-JUNE-04	ASW	RF	BS	TU
1	ISSUED FOR CONSTRUCTION	27-MAR-04	ASW	RF	BS	TU
0	ISSUED FOR CONSTRUCTION	14-JAN-04	ASW	KJ/RD	AU/BS	TU
NO.	DESCRIPTION	DATE	BY	CHKD	RVD	APVD

CONTRACTOR REVISIONS

PT. CHIYODA INTERNATIONAL INDONESIA

PT. Sempec Indonesia

CONTRACT | JOB E3X01

PetroChina International Jabung Ltd.

BETARA COMPLEX DEVELOPMENT

PIPING AND INSTRUMENTATION DIAGRAM
BETARA GAS PLANT
NGL RUNDOWN COOLER

SCALE : NTS

DOCUMENT BCD3-605-42-PID-1-011-02

REVISION 7

FILE NAME : \BCD3-605-42-PID-1-011-02.Rev.DWG