
TAG NO.	605-K-101A/B (2x100%)	
SERVICE	CONDENSATE STRIPPER OVHD COMPRESSORS	
CAPACITY	14.5842 (EACH)	MMSCFD
SUC. PRESS.	251	PSIA
DIS. PRESS.	739.5	PSIA
DRIVER	850	KW

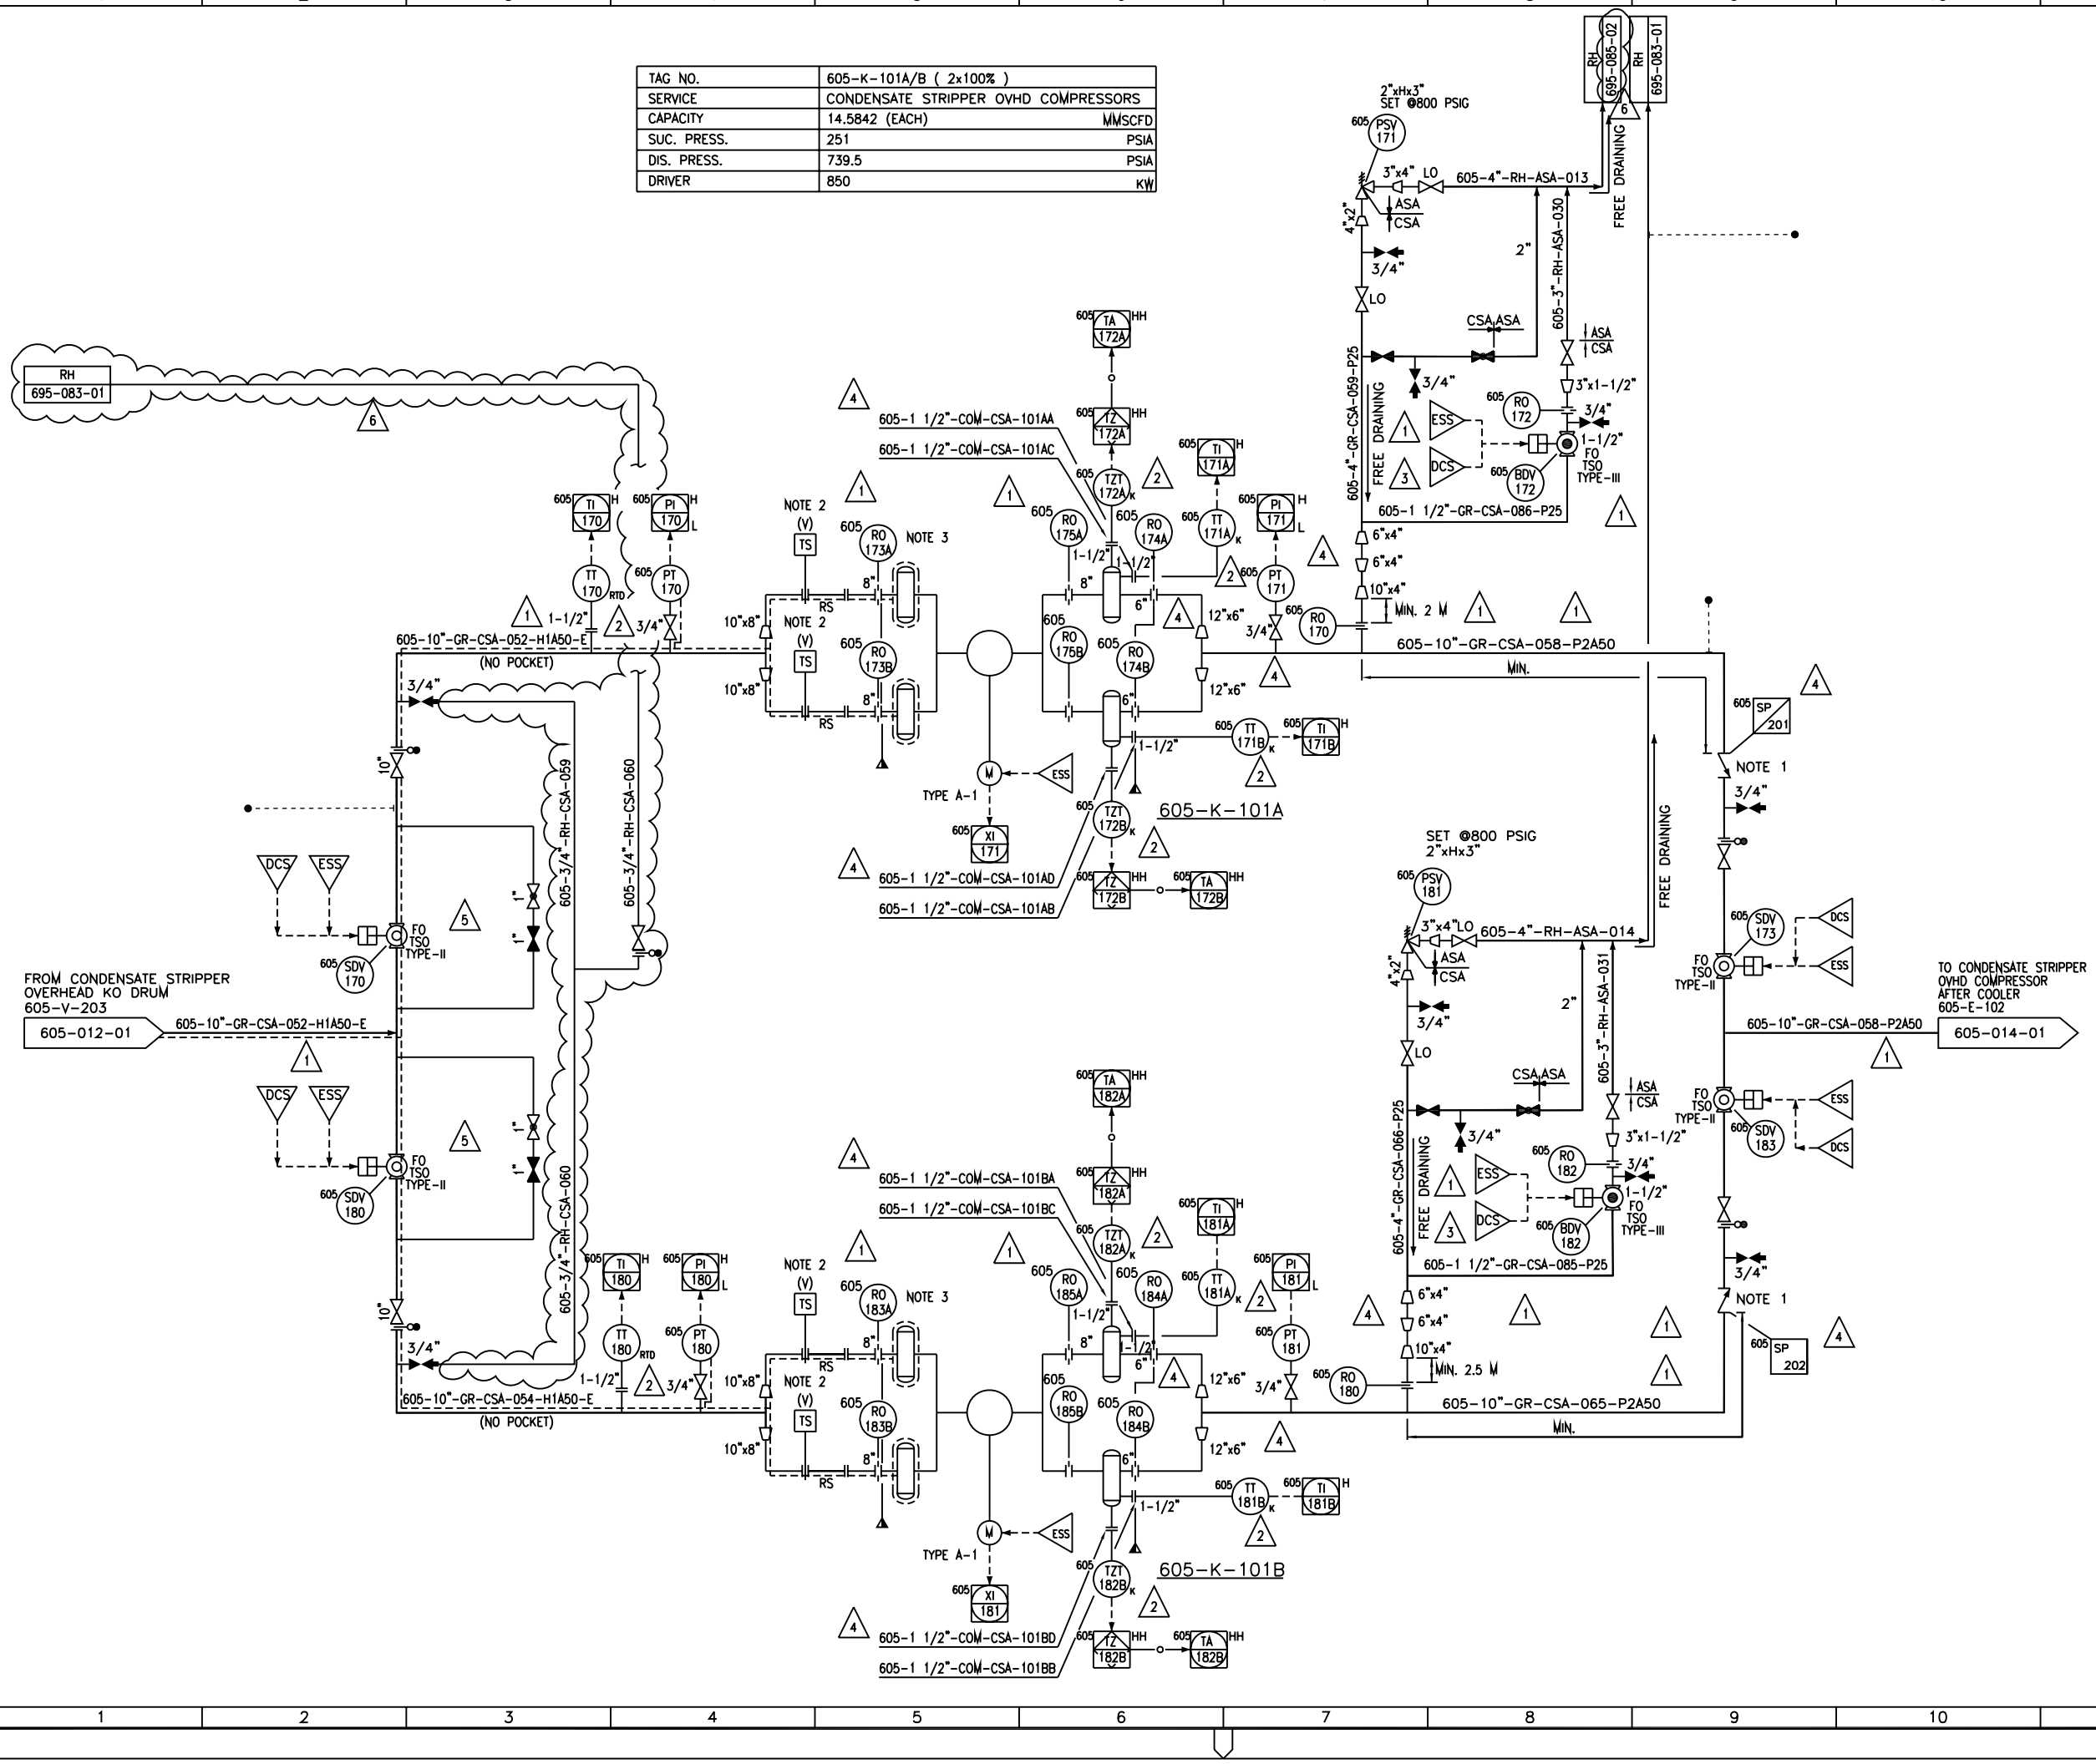

NOTES

1. NON SLAM TYPE.
2. STRAINER ELEMENT IS SUPPLIED BY COMPRESSOR VENDOR, HOUSING IS SUPPLIED BY CONTRACTOR.
3. VOLUME BOTTLES SHALL BE HEAT TRACED AND INSULATED.
4. TO PROVIDE MANUAL OVERIDE FROM DCS.
5.

SUPPLY SCOPE

BY VENDOR | BY CONTRACTOR

AS BUILT

BCD3-000-42-PID-I-001-01 TO 012	P&ID SYMBOLS

NO. | REFERENCE DOCUMENT

REV.	ISSUED	PURPOSE	LDE	PEM	PM	STATUS	DATE

COMPANY STATUS

NO.	DESCRIPTION	DATE	BY	CHKD	RVD	APVD
6	RE-AS BUILT					
5	AS BUILT	18-JULY-05	non	AM	BS	TU
4	ISSUED FOR CONSTRUCTION	11-MAY-05	ASH	AM	BS	TU
3	ISSUED FOR CONSTRUCTION	09-SEPT.-04	ASH	RF	BS	TU
2	ISSUED FOR CONSTRUCTION	19-JUNE-04	ASH	RF	BS	TU
1	ISSUED FOR CONSTRUCTION	27-MAR-04	ASH	RF	BS	TU
0	ISSUED FOR CONSTRUCTION	14-JAN-04	ASH	KJ RID	AU BS	TU
E	ISSUED FOR HAZOP	19-SEPT-03	ASH	KJ RID	AU BS	TU
D	ISSUED FOR HAZOP	08-SEPT-03	ASH	KJ RID	AU BS	TU
C	THE APPROVAL	7-AUGUST-03	ASH	KJ RID	AU BS	TU
B	INTERNAL REVISION	10-MAY-03	ASH	KJ RID	AU BS	TU
A	ISSUED FOR REVIEW	01-APR-03	ASH	KJ RID	AU BS	TU

CONTRACTOR REVISIONS

PT. CHIYODA INTERNATIONAL INDONESIA | PT. Sempec Indonesia

CONTRACT | JOB E3X01

PetroChina International Jabung Ltd.

BETARA COMPLEX DEVELOPMENT

PIPING AND INSTRUMENTATION DIAGRAM
BETARA GAS PLANT
CONDENSATE STRIPPER OVERHEAD COMPRESSOR
(2/3)

SCALE : NTS

DOCUMENT: BCD3-605-42-PID-1-013-01

REVISION: 6

FILE NAME : \BCD3-605-42-PID-1-013-01.DWG