
TAG NO.	605-K-102 B	
SERVICE	INLET COMPRESSOR B	
CAPACITY	123.3	MMSCFD
SUC. PRESS.	345	PSIG
DIS. PRESS.	745	PSIG
DRIVER	5226	HP

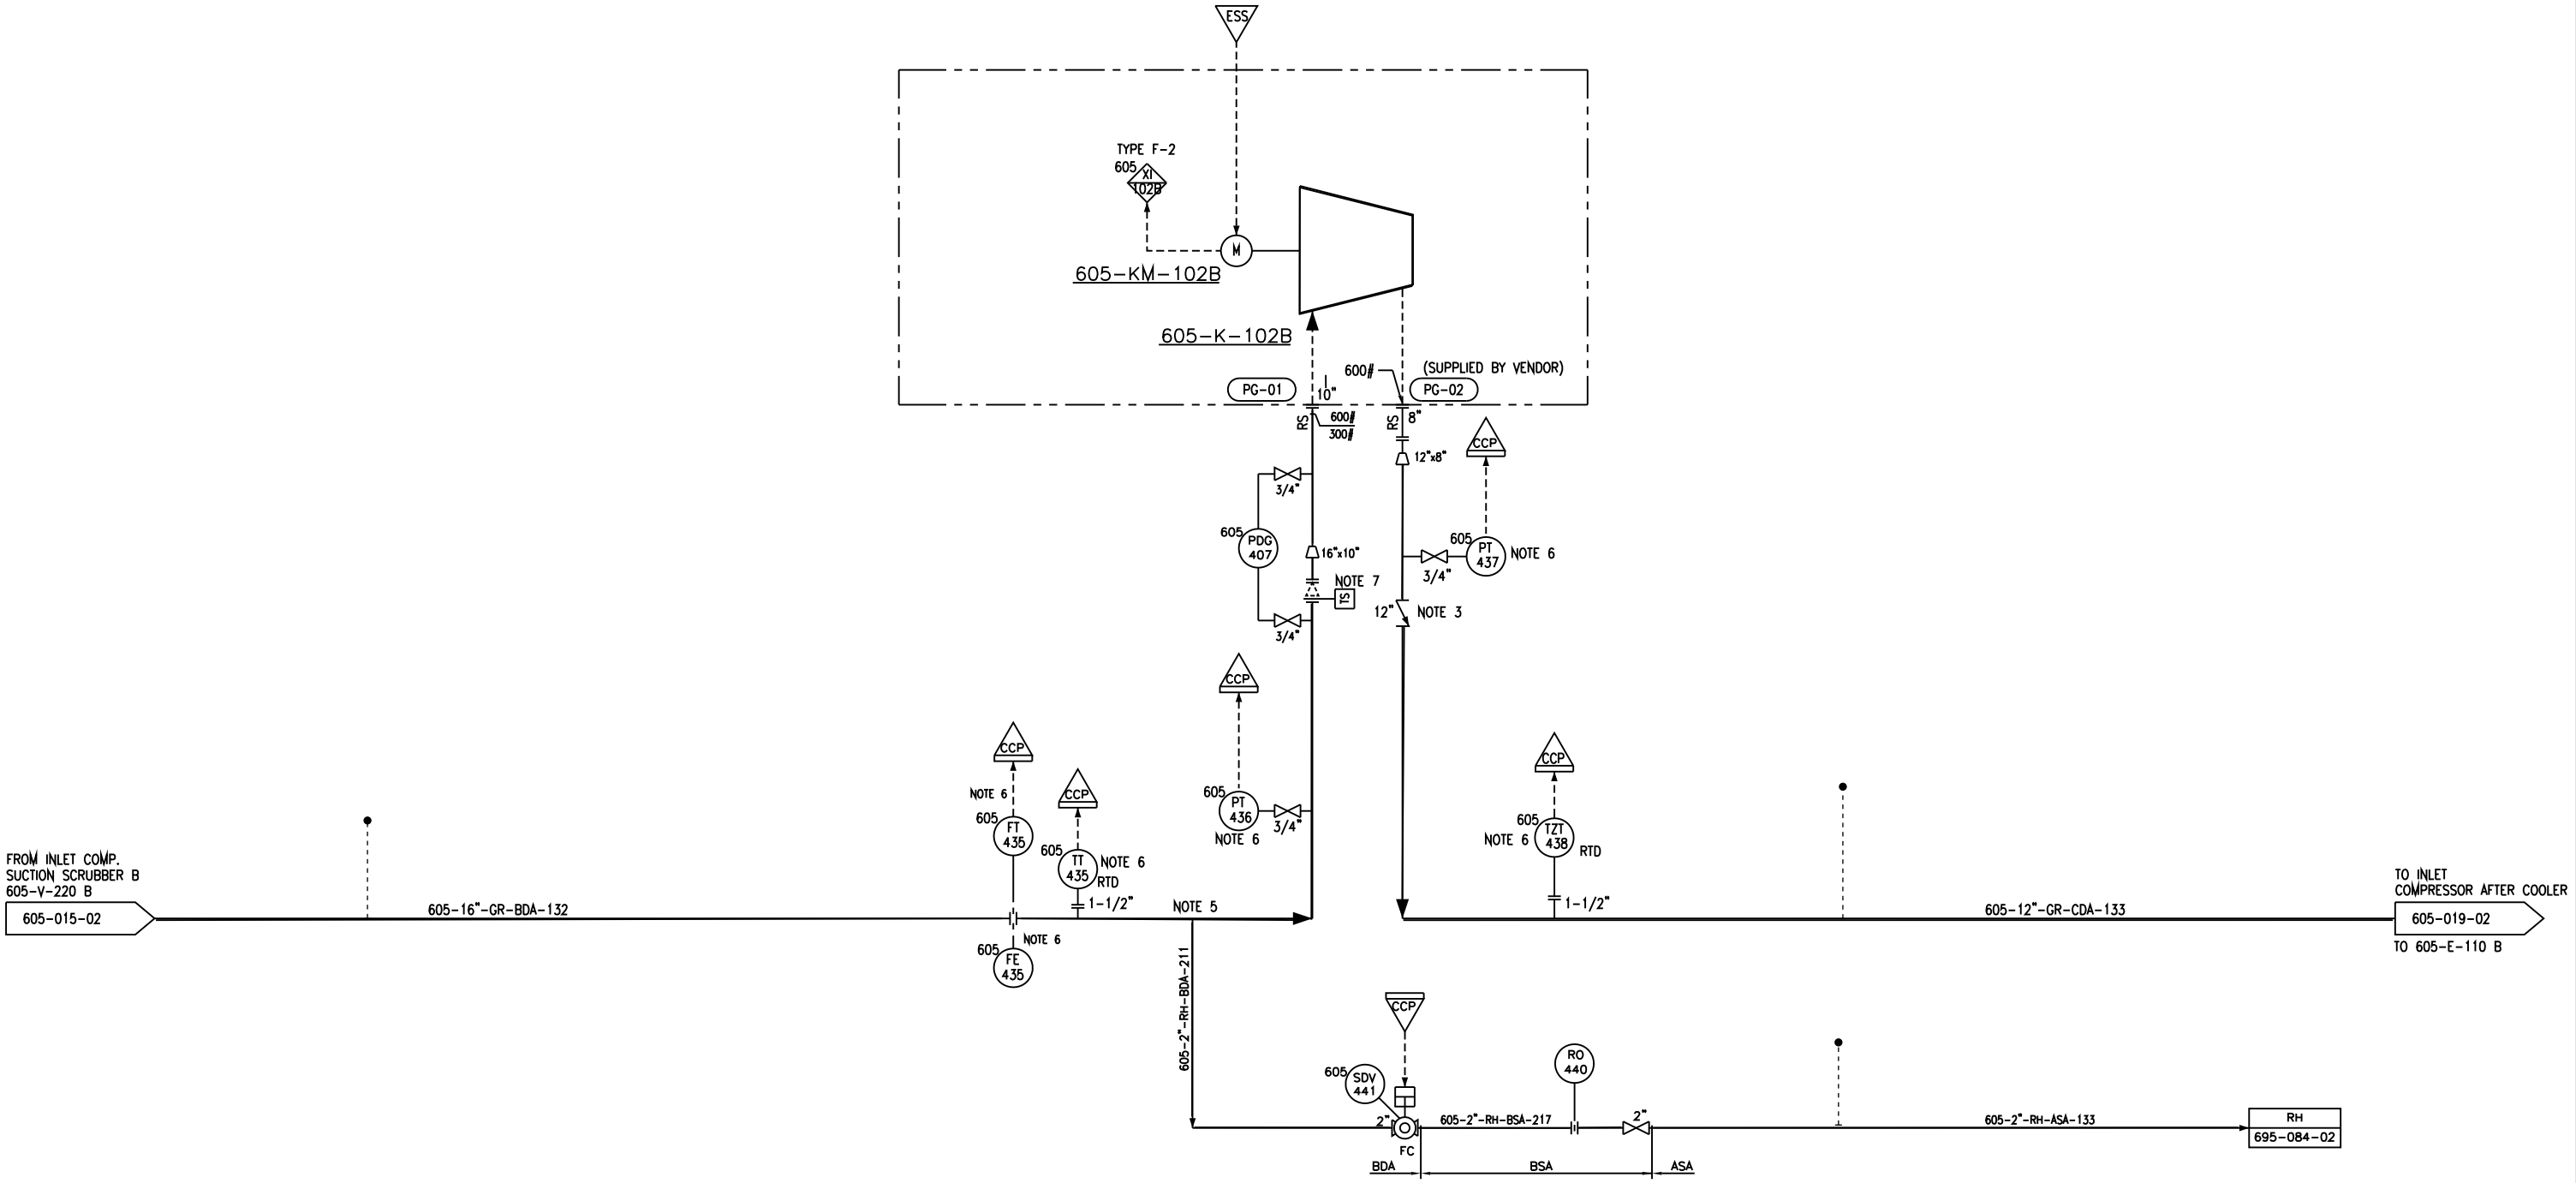

FINAL APPROVAL BY COMPANY			
DRAWING NO.	REV. NO.	APPROVED BY	DATE

NOTES :

1. COMPRESSOR PACKAGE CONTAINS SYSTEM-ANTI SURGE CONTROLLER, LUBE OIL SYSTEM, SEAL GAS, AND CONTROL PANEL.
2. DELETED.
3. NON SLAM CHECK VALVE.
4. DELETED.
5. LOW POINT DRAIN FOR COMPRESSOR START SEQUENCE.
6. FLOW TRANSMITTER, TEMPERATURE TRANSMITTERS, AND PRESSURE TRANSMITTERS ARE SUPPLIED BY INLET COMPRESSOR VENDOR.
7. TS SUPPLIED BY INLET COMPRESSOR VENDOR.

REFERENCE DWG NO	DESCRIPTION
BCD4-000-42-PID-1-001-01~015	P&ID SYMBOLS

REVISIONS

REV	DRFT'G	DATE	DESCRIPTION	PREPARED BY	CHECKED BY	APPROVED BY	APPROVED BY
1	NUR	21/06/11	AS BUILT	PBS/AW	SPD	ECR/RPS	RSD
0	EB	12/01/10	APPROVED FOR CONSTRUCTION	PBS/AW	SPD	ECR/RPS	RSD
C	EB	23/10/09	FOR ACCEPTANCE	PBS/AW	SPD	ECR/RPS	RSD
B	EB	04/09/09	FOR ACCEPTANCE	PBS/AW	SPD	ECR/RPS	RSD
A	DP	24/08/09	FOR DISCIPLINE COORDINATION	PBS/AW	SPD	ECR/RPS	RSD

CLIENT

PetroChina International Jabung Ltd.

Betara Complex Development

Job No. : BCD - 335 - CA

CONTRACTOR

PT MEINDO ELANG INDAH PT CAKRA NUSA DARMA PT SINGGAR MULIA

TITLE

PIPING AND INSTRUMENTATION DIAGRAM
BETARA GAS PLANT
INLET COMPRESSOR-B

SIZE	SCALE	DRAWING No.	SHT No.	REV.
A3	NTS	BCD4-605-42-PID-3-016-02	2 OF 3	1

CAD FILE NAME : BCD4-605-42-PID-3-016-02_1.DWG