
TAG. NO	605-E-110 C
SERVICE	INLET COMPRESSOR AFTER COOLER C
TYPE/SURFACE (FIN)	FORCED / NOTE 2 M2
HEAT DUTY	18.18 MMBTU/HR
DESIGN PRESS.	910 / FV PSIG
DESIGN TEMP.	300/73 ° F
DRIVER	40 HP
HEAD MATERIAL	SS 316L
TUBE MATERIAL	SS 316L

TAG NO.	605-V-221 C
SERVICE	INLET COMPRESSOR DISCHARGE SCRUBBER C
ID x TT	850 x 2625 MM
DESIGN PRESS.	910 / FV PSIG
DESIGN TEMP.	200/70 ° F
INSULATION	NONE MM
MATERIAL	CS + SS 316L CLAD
TRIM MATERIAL	SS 316 L

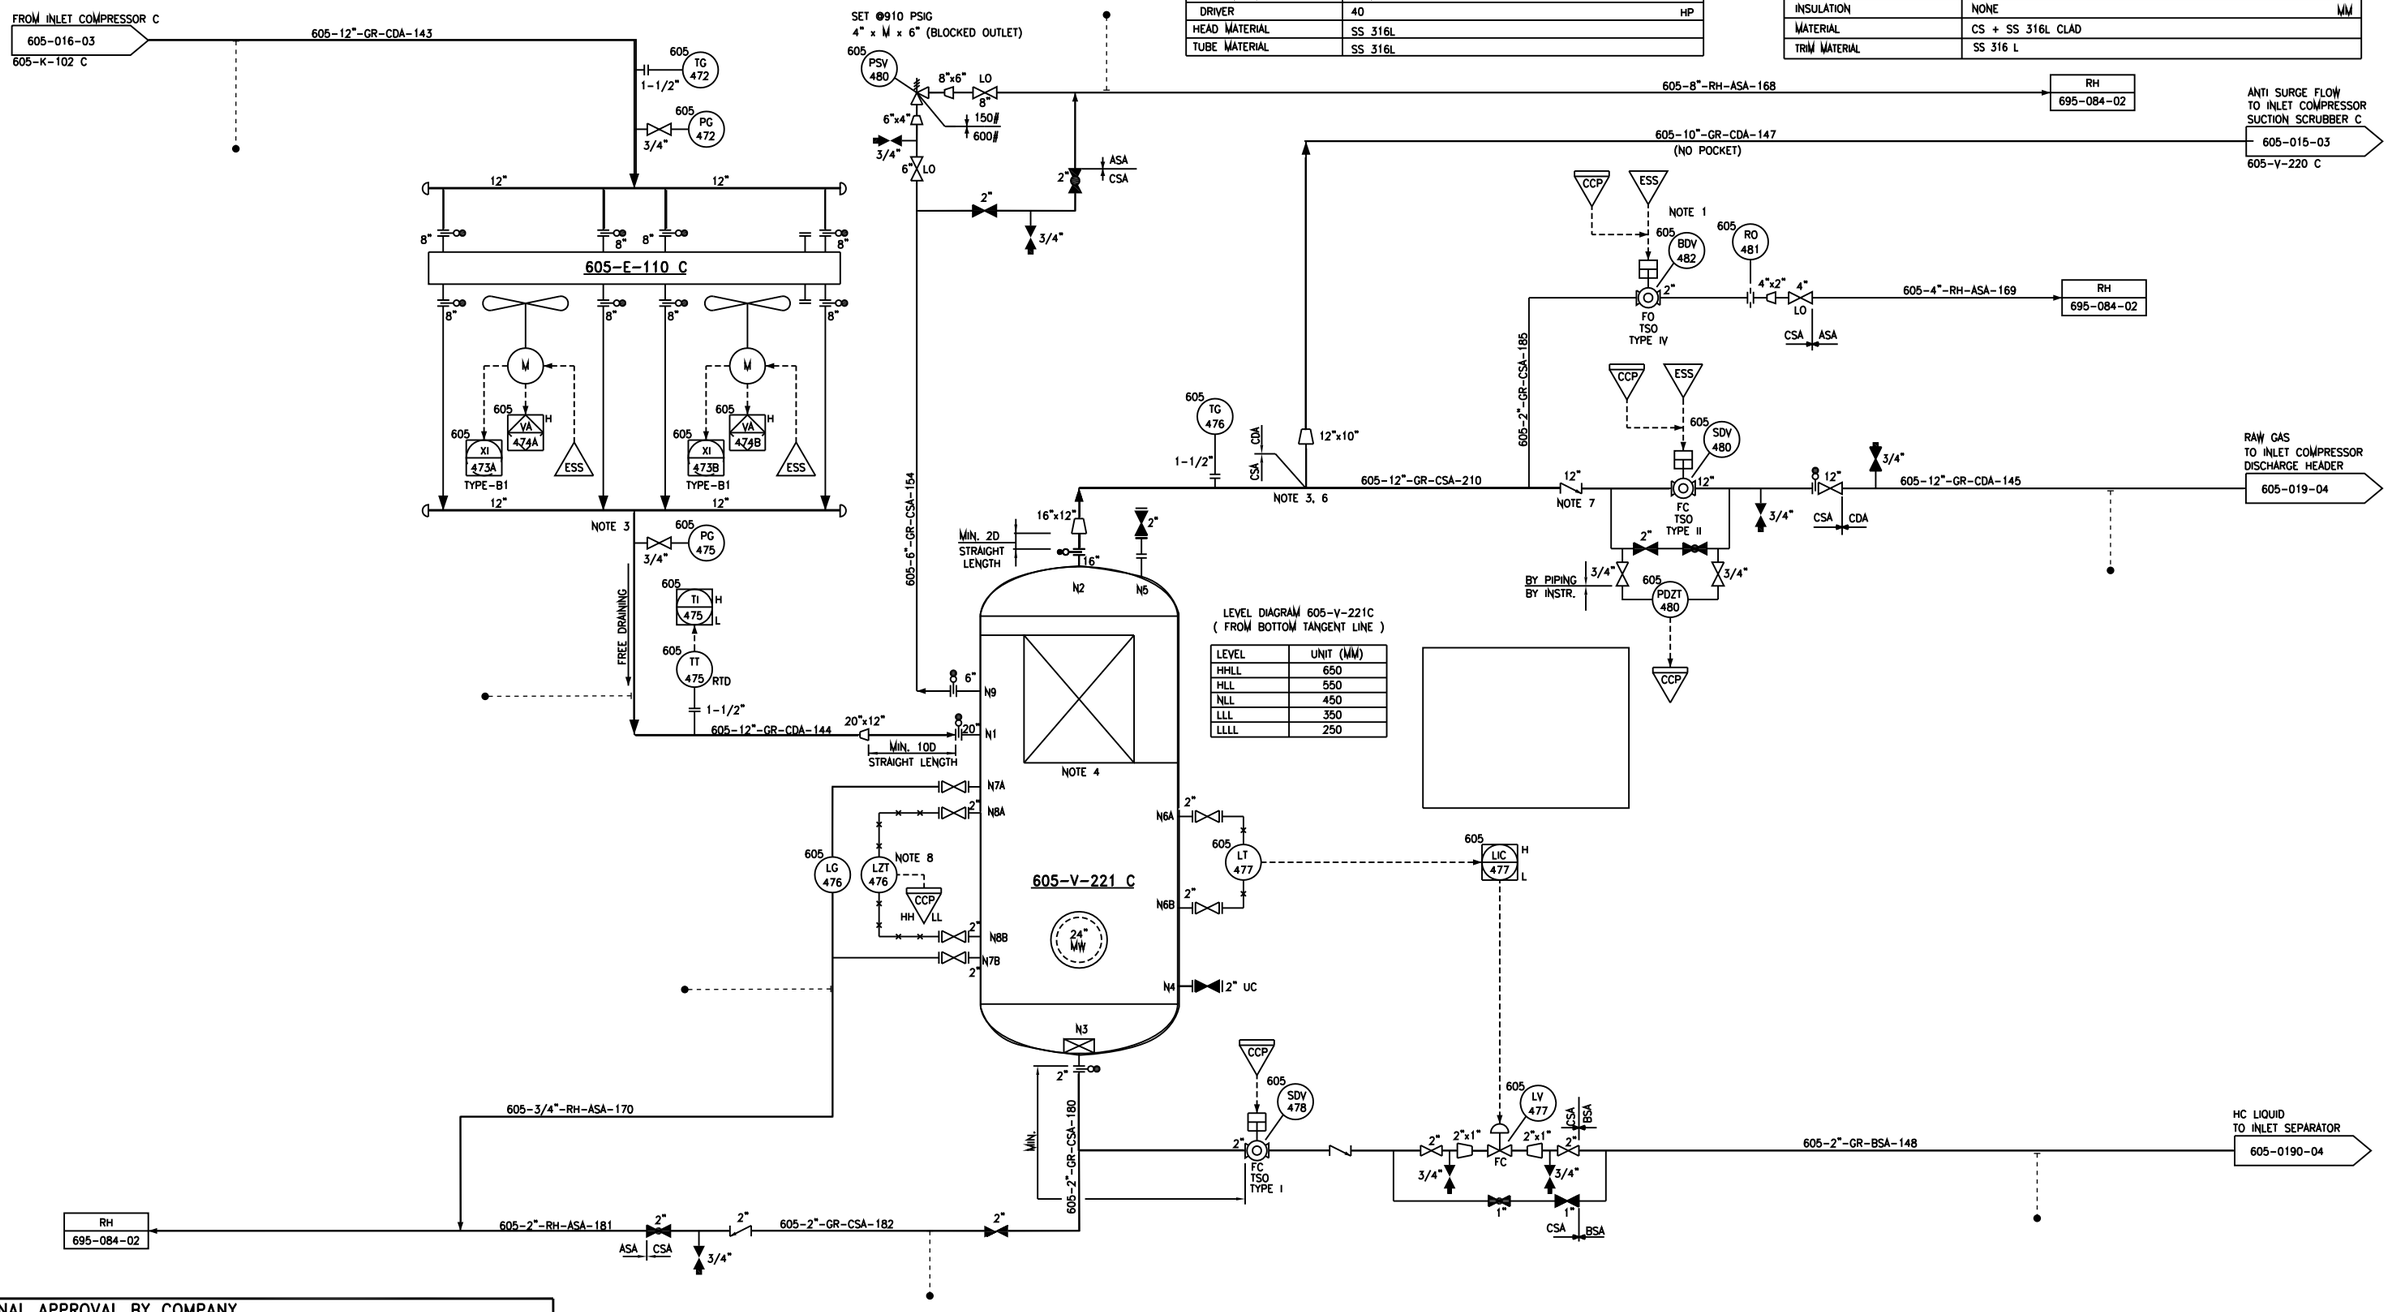

FINAL APPROVAL BY COMPANY			
DRAWING NO.	REV. NO.	APPROVED BY	DATE

NOTES :

1. TO PROVIDE MANUAL OVERRIDE FROM DCS.
2. VENDOR SHALL SPECIFY SURFACE AREA REQUIRED
3. USE EQUAL TEES TO MINIMIZE FLOW INDUCED RESONANCE ON NON-FLOWING LINES CONNECTIONS
4. VANE TYPE INTERNALS SHALL BE APPLIED.
5. DELETED
6. DISSIMILAR WELDING
7. NON SLAM CHECK VALVE
8. SDV-418 CLOSES IF LZT-476 ON LOW-LOW ALARM STATUS AND COMPRESSOR SHUTDOWN IF LZT-476 ON HIGH-HIGH ALARM STATUS.

REFERENCE DWG NO	DESCRIPTION
BCD4-000-42-PID-3-001-01~15	P&ID SYMBOLS

REVISIONS

REV	DRFT'G	DATE	DESCRIPTION	PREPARED BY	CHECKED BY	APPROVED BY	APPROVED BY
1	NUR	08/07/11	AS BUILT	PBS/AW	SPD	ECR/RPS	RSD
0	EB	05/02/10	APPROVED FOR CONSTRUCTION	PBS/AW	SPD	ECR/RPS	RSD
C	EB	23/10/09	FOR ACCEPTANCE	PBS/AW	SPD	ECR/RPS	RSD
B	EB	04/09/09	FOR ACCEPTANCE	PBS/AW	SPD	ECR/RPS	RSD
A	DP	24/08/09	FOR DISCIPLINE COORDINATION	PBS/AW	SPD	ECR/RPS	RSD

CLIENT

PetroChina International Jabung Ltd.

Betara Complex Development

Job No. : BCD - 335 - CA

CONTRACTOR

PT MEINDO ELANG INDAH PT CAKRA NUSA DARMA PT SINGGAR MULIA

TITLE

PIPING AND INSTRUMENTATION DIAGRAM
BETARA GAS PLANT
INLET COMP. AFTER COOLER C AND DISCH. SCRUBBER C

SIZE	SCALE	DRAWING No.	SHT No.	REV.
A3	NTS	BCD4-605-42-PID-3-019-03	3 OF 4	1

CAD FILE NAME : BCD4-605-42-PID-3-019-03_1.DWG